


Record & Plat of a survey made on Sec. 34, T. 3, R. 14 E.  
Nov. 1<sup>st</sup> 1864 by S. H. Locke Co. Surveyor Johnston

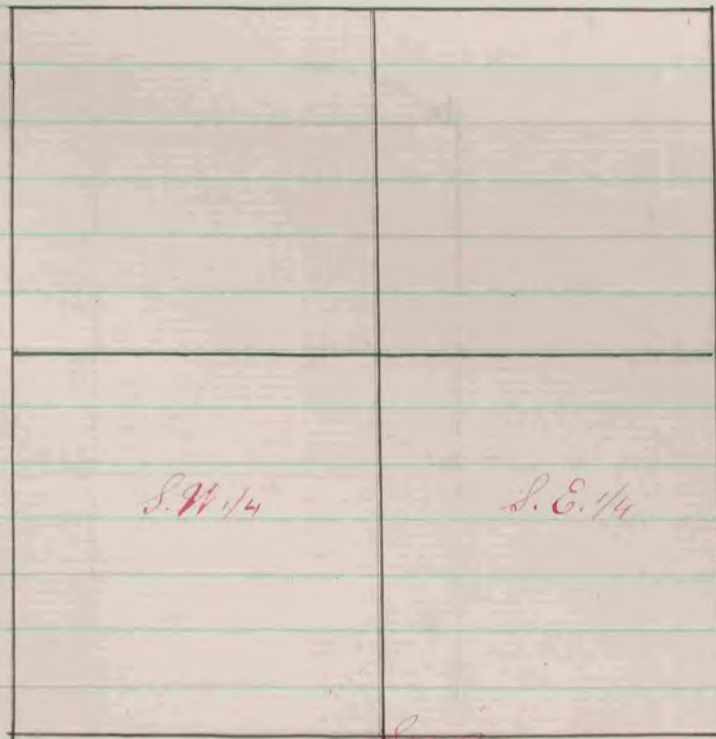

RECORDED  
1864  
BY  
S. H. LOCKE

Sup. Post  
Found old stake - set limestone 20x12x5

Record & Plat of a survey made on Sec. 26, T. 3, N. R. 14 E.  
Nov. 1<sup>st</sup> 1864 by S. H. Locke Co. Surveyor Johnston