


The above is a record & plat of a survey made on Sec. 28 Exeter Jan. 4, 1883 by Edward Ruger Co. Surveyor.

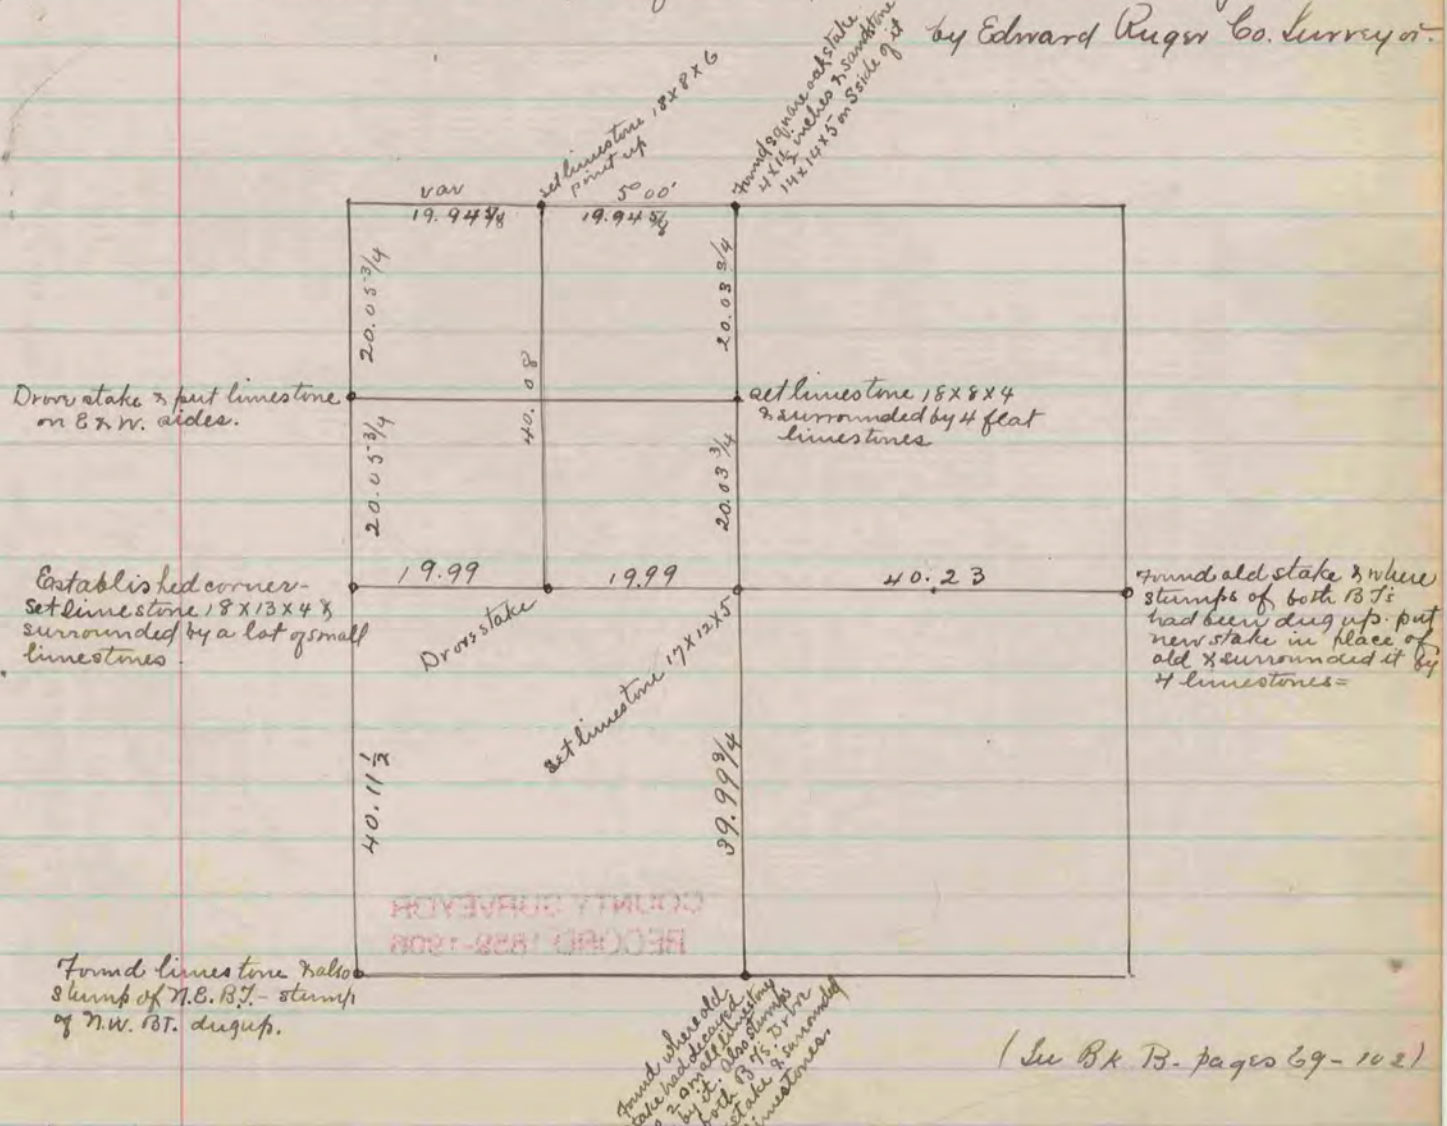

The above is a record & plat of a survey made by me on Sec 35-34 Bk. June 22, 1882. Edward Ruger Co. Surveyor.