


Found old stake & hard head
stone on West side of it. Drove
new stake in place of old one
and surrounded it with 4 hard
head stones.

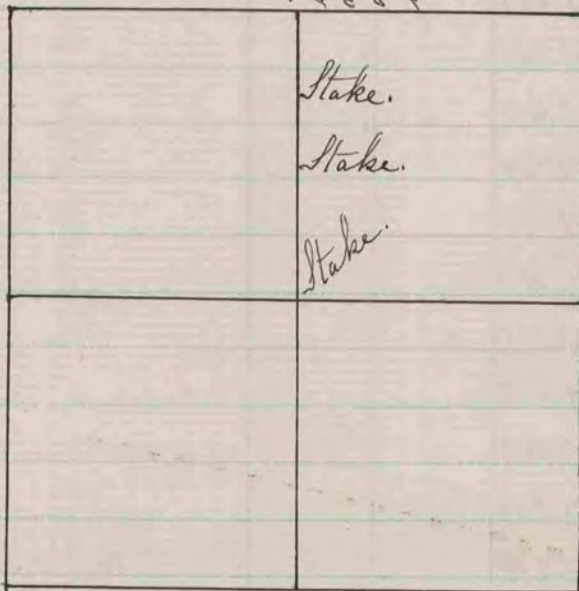

Found corner established by self
in former survey. Drove new
stake deep - laid flat lime stone
on top of stake and put on top of
flat lime stone a lime stone
10x5x2 1/2.

The above is a plat and record of a survey made by
me this 18th day of November 1874 on Sec. 20,
Rock - The survey was made to establish
the North & South quarter line. The stakes
on the quarter line were not driven to establish
corners, but simply to mark the quarter line.

Edward Ruger
County Surveyor.