


Hand Stamp of B.T.s of old stakes  
A Record & Plat of a Survey made on Sec. 6, Tullahoma, January 10 and 11  
1865 by S.D. Locke County Surveyor in & for Rock County This

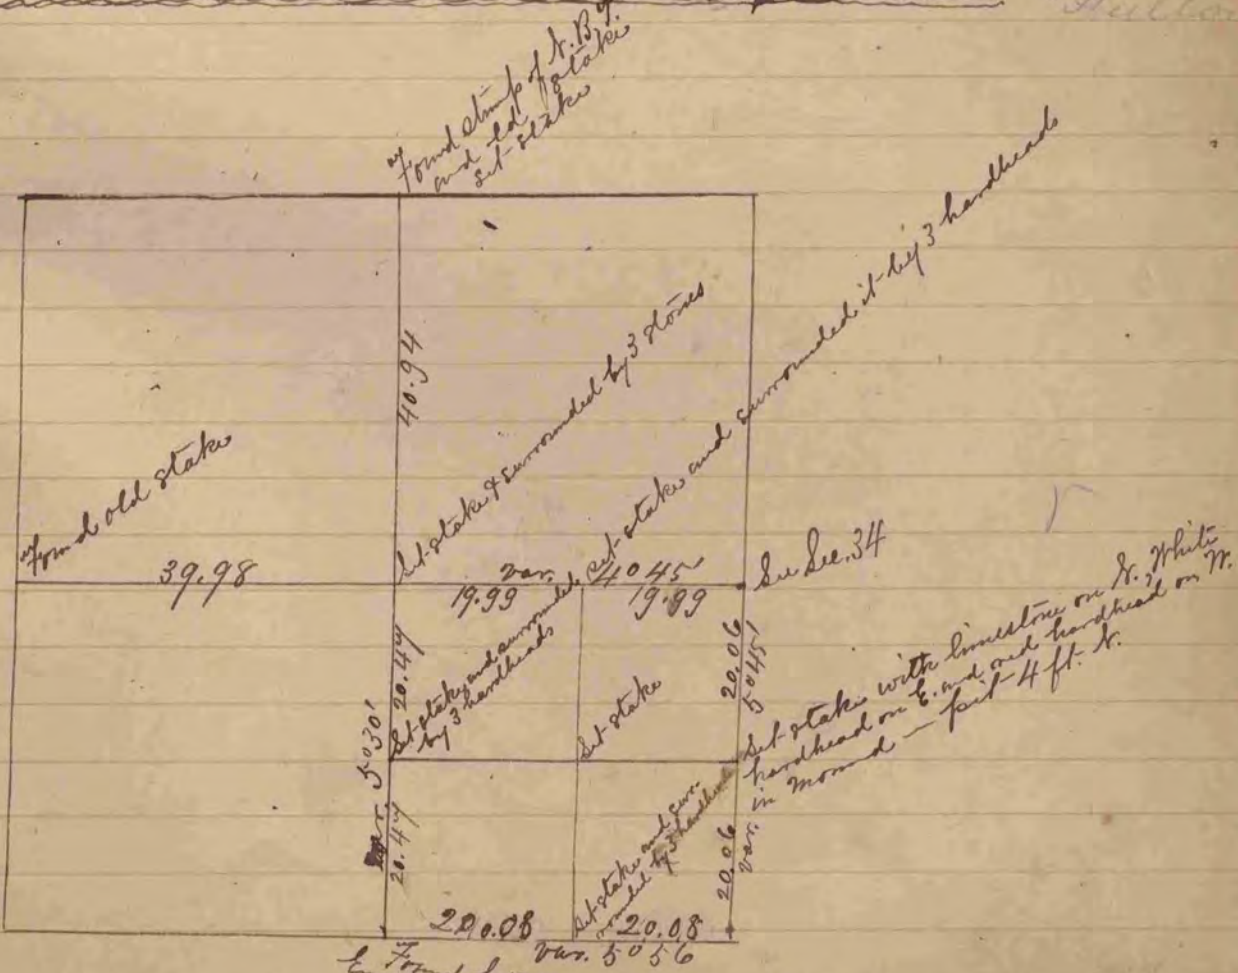

A Record & Plat of a Survey made on Sec. 33, Tullahoma by  
S.D. Locke County Surveyor