



COUNTY SURVEYOR
RECORD 1 1851-1869

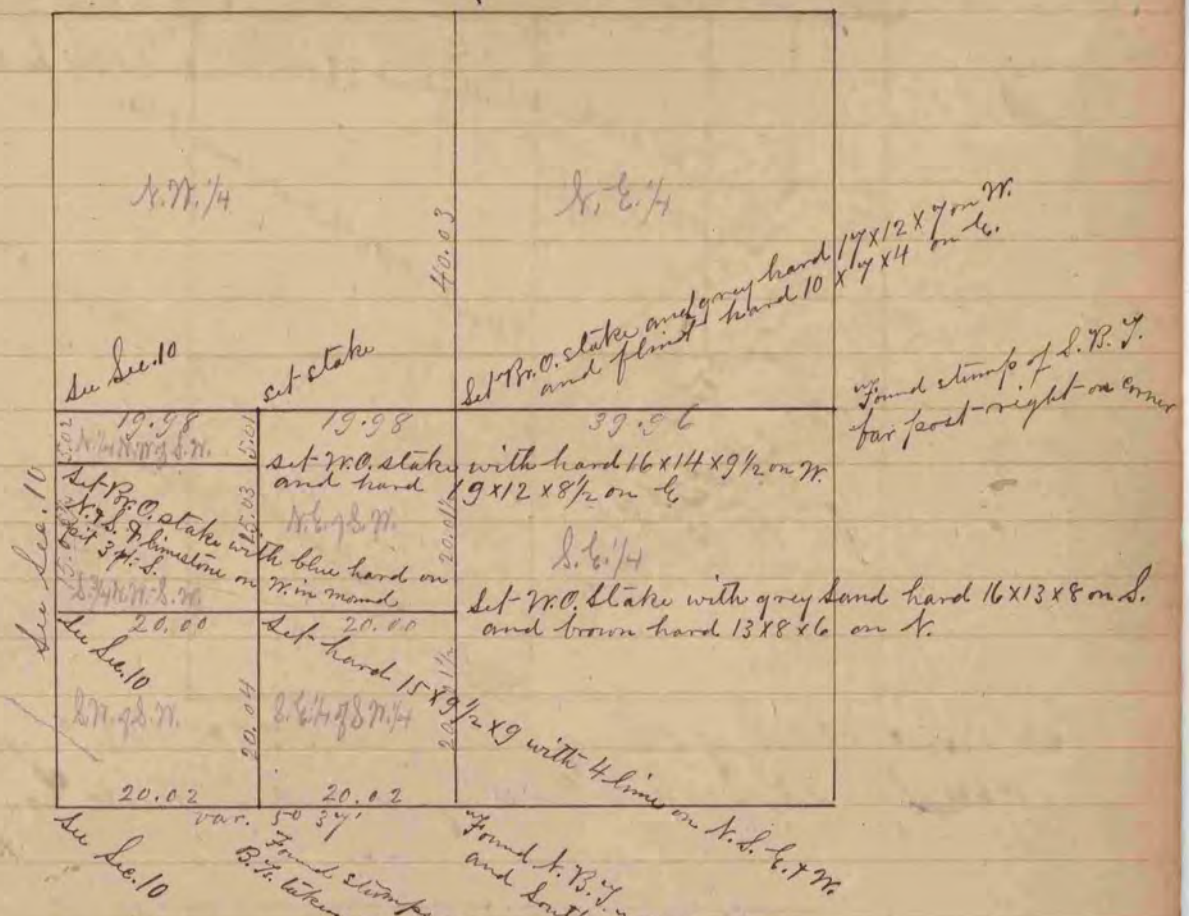

A Record & Plat of a Survey made on
Sec. 11, T. 1, R. 13 E. May 18, 1864, by S. D. Locke
Co. Survs. in and for Rock County Wis.

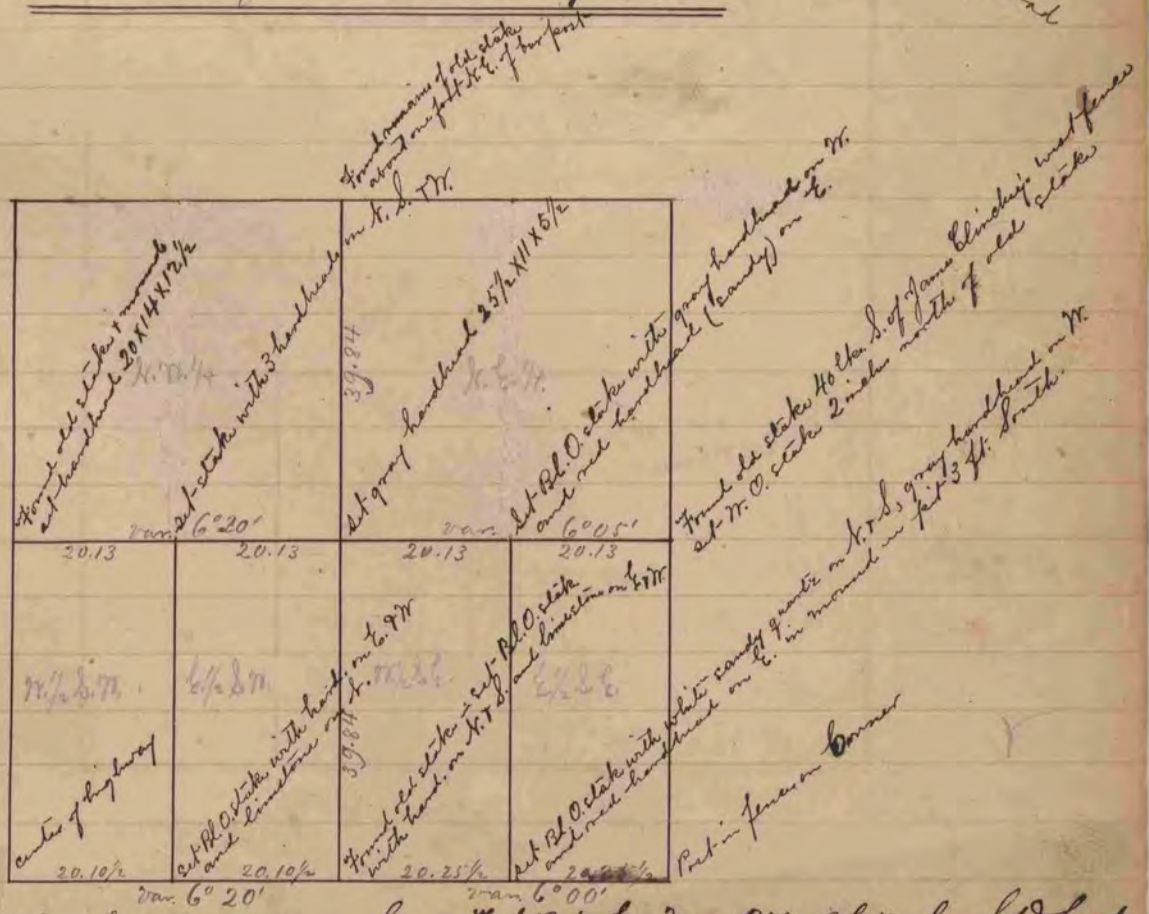

A Record & Plat of a Survey made on Sec. 8, T. 1, R. 12 E., May 27, 1864 by S. D. Locke
Co. Survs. in and for Rock Co. Wis.