



Below is a correct Record & Plot of a Survey made by me July 6th & 7th 1869 on Sec 27 T. 3 R. 10 (Magalia) R. K. Lee Dep. Co. Surveyor.

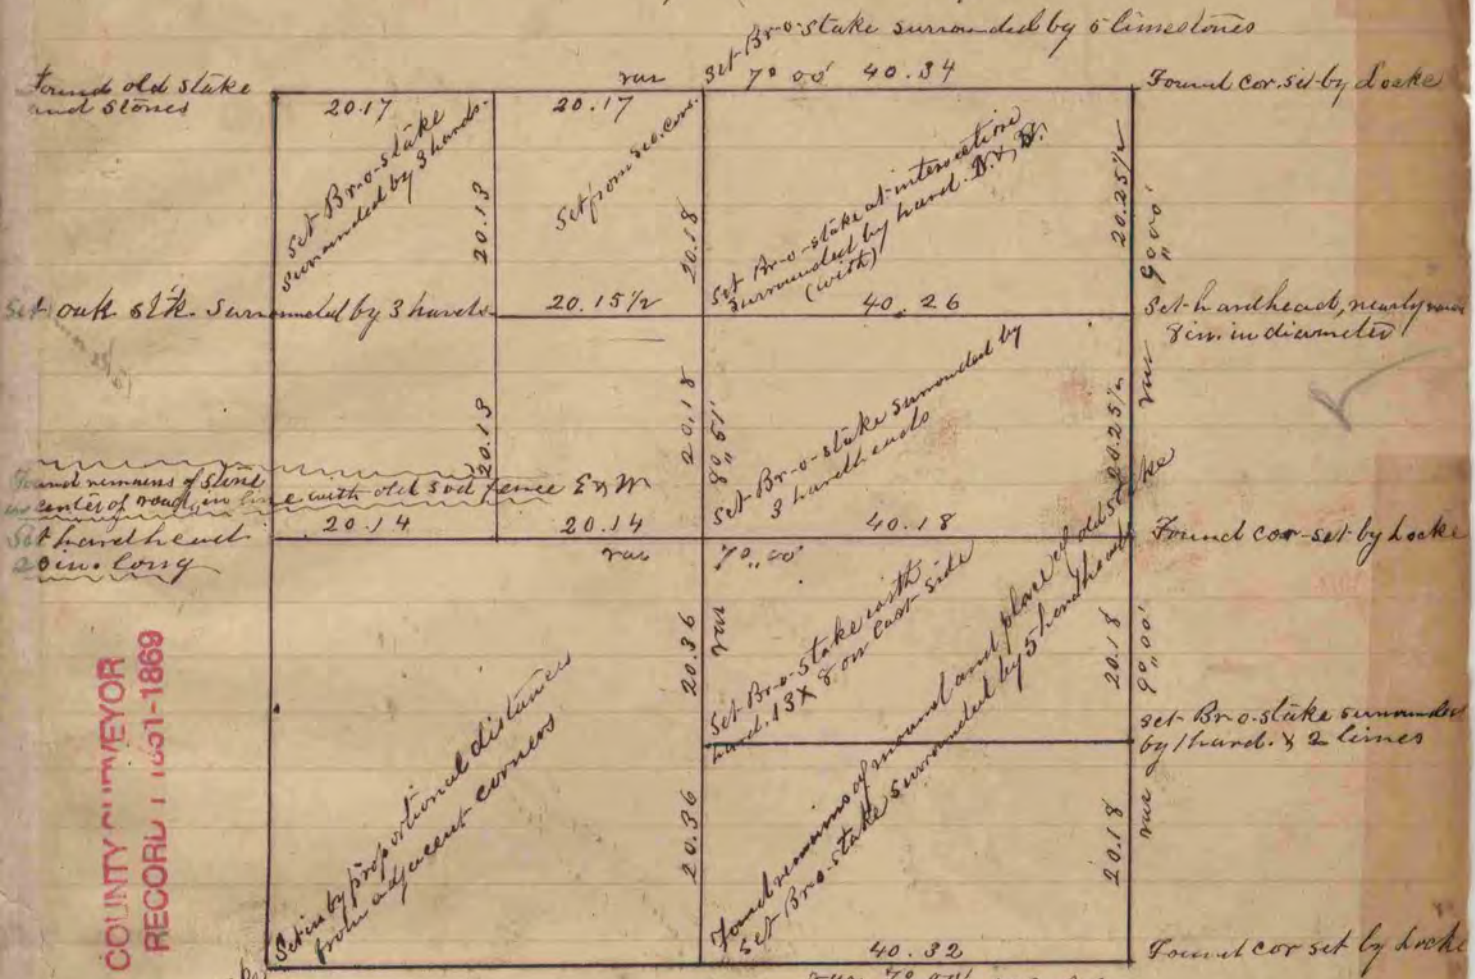

COUNTY SURVEYOR
RECORD 1 1631-1869

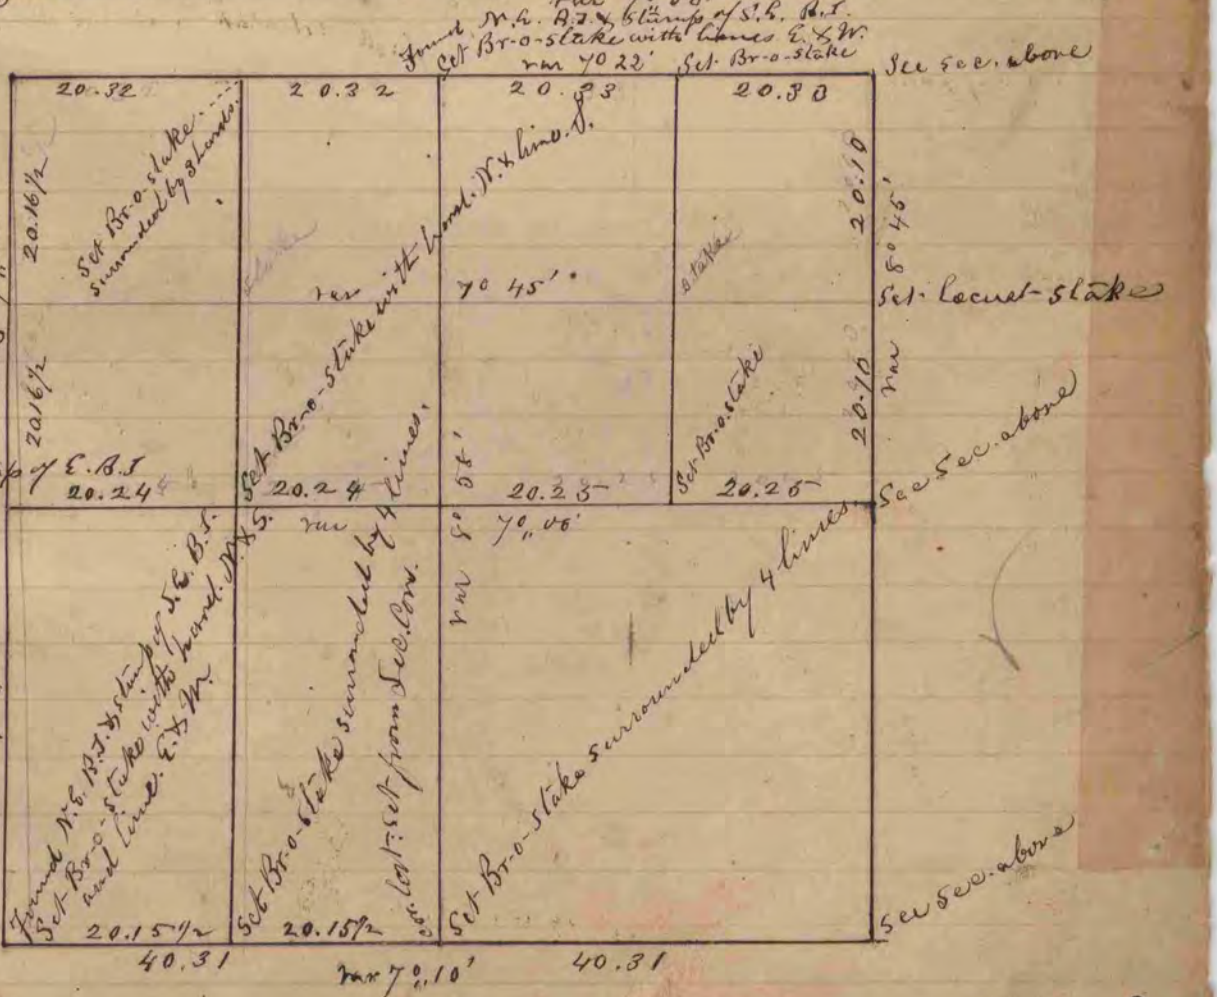

The above is a correct Record & Plot of a Survey made by me July 8th & 9th 1869 on Sec. 28, T. 3 R. 10 (Magalia) R. K. Lee, Dep. Co. Surveyor