




Found stamp of M. B. T. and where he was dug out and old stake set with flat limestone on N. and S. and W. and E.

The above is a correct Record & Plat of a Survey made by me Nov. 29, 1866, on Sec. 35, Town of Clinton, S. D. Locke, County Surveyor for Rock Co. Wis.

Found stamp of B. T. & old stake
 Found cor. set by Raper
 set stake with handhead on N. & S. in mound
 Found B. T. taken by Raper
 set stake with quartz stone on E. and W.
 Found stamp of B. T. & old stake
 Found cor. set by Raper
 set stake with handhead on N. & S. in mound
 Found B. T. taken by Raper
 set stake with quartz stone on E. and W.

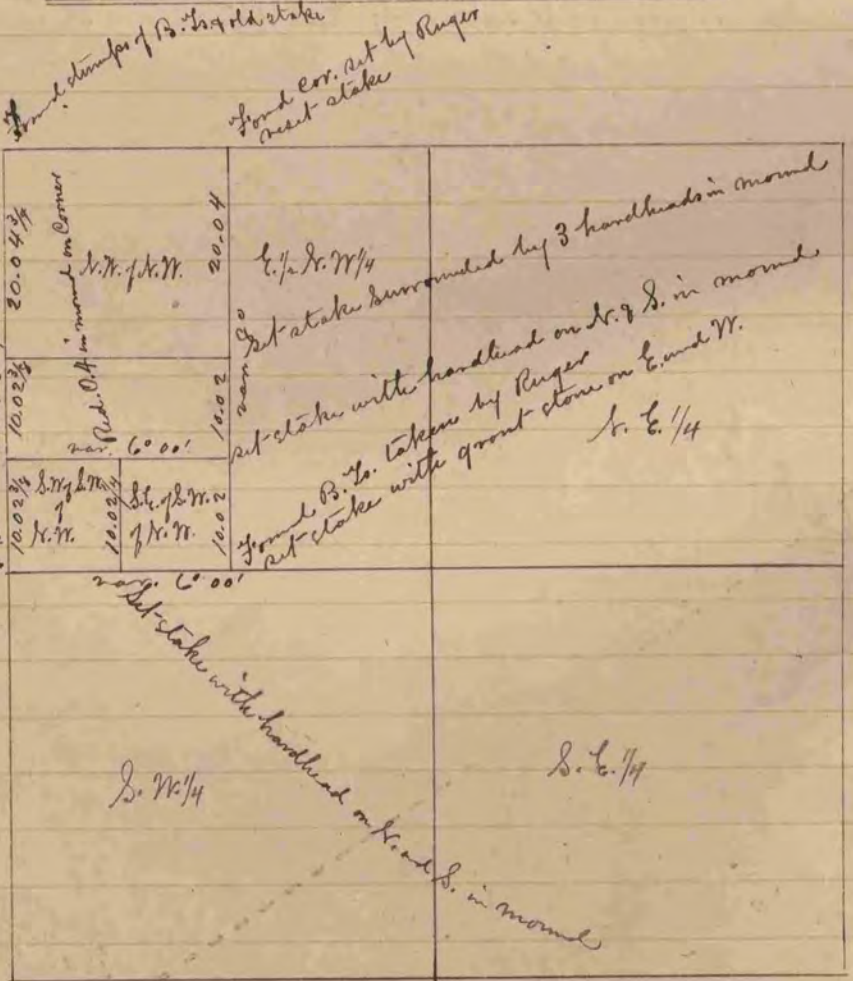

The above is a correct Record & Plat of a Survey made by me Dec. 18, 1866, on Sec. 24, Town of Harmony, S. D. Locke County Surveyor for Rock County Wis.