


The above is a Correct Record of Plat of a Survey made by me June 3, 1867, on Dec. 35, Jamesville  
S.D. Locke County Surveyor for Rock Co., Wis.

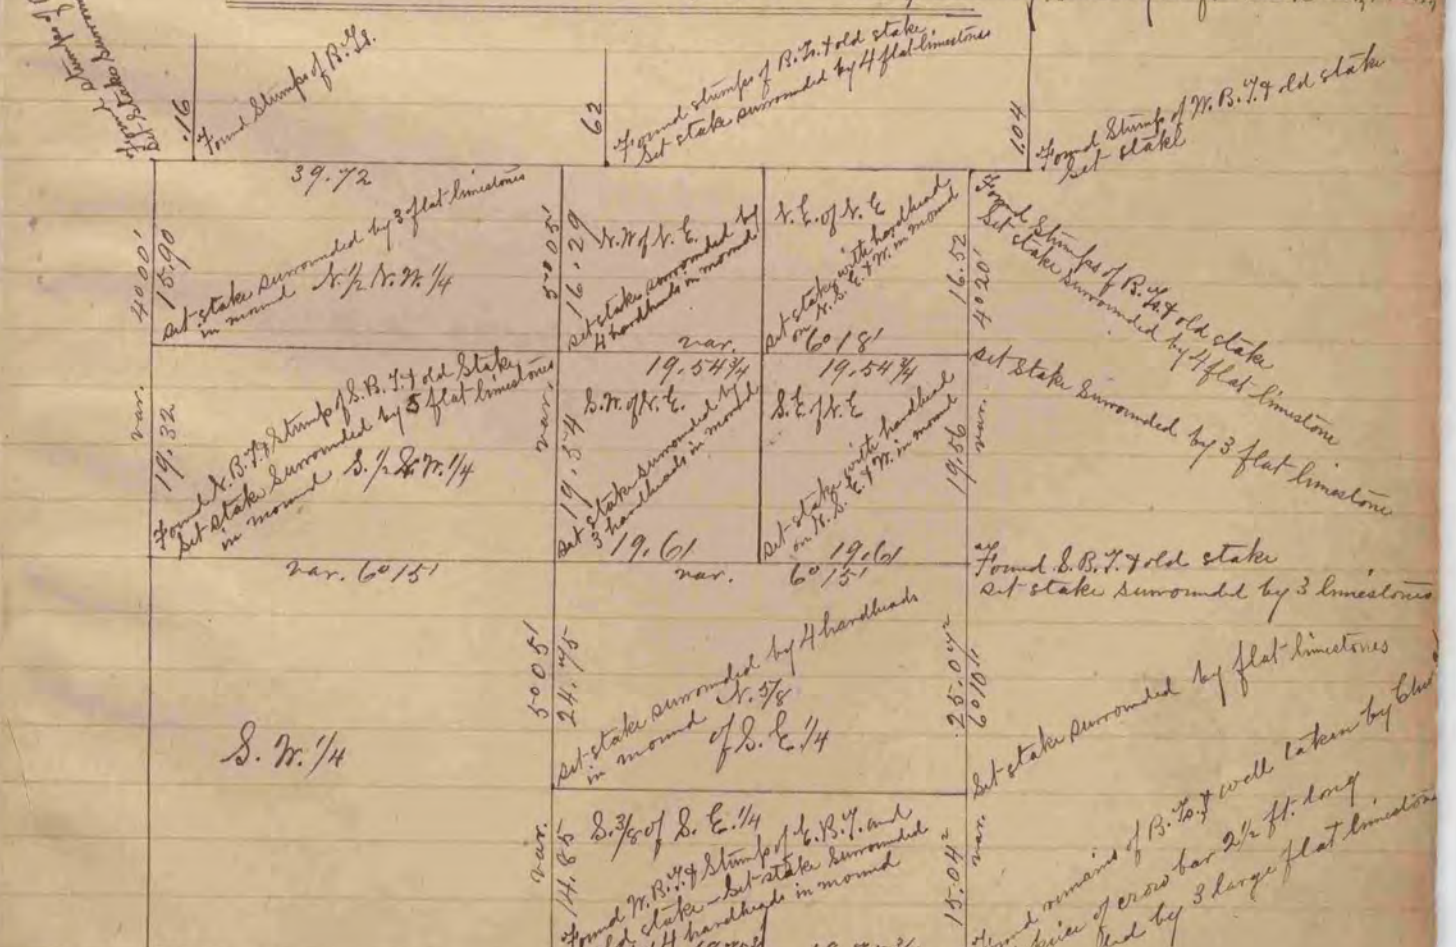

The above is a Correct Record of Plat of a Survey made by me June 9 & 10, 1867, on Dec. 4, Spring Valley  
S.D. Locke County Surveyor Rock Co., Wis.