


The above is a correct Record & Plat of a Survey made by me April 26, 1867, on Sec. 15, Rock  
S. D. Locke, County Surveyor for Rock Co., Miss.

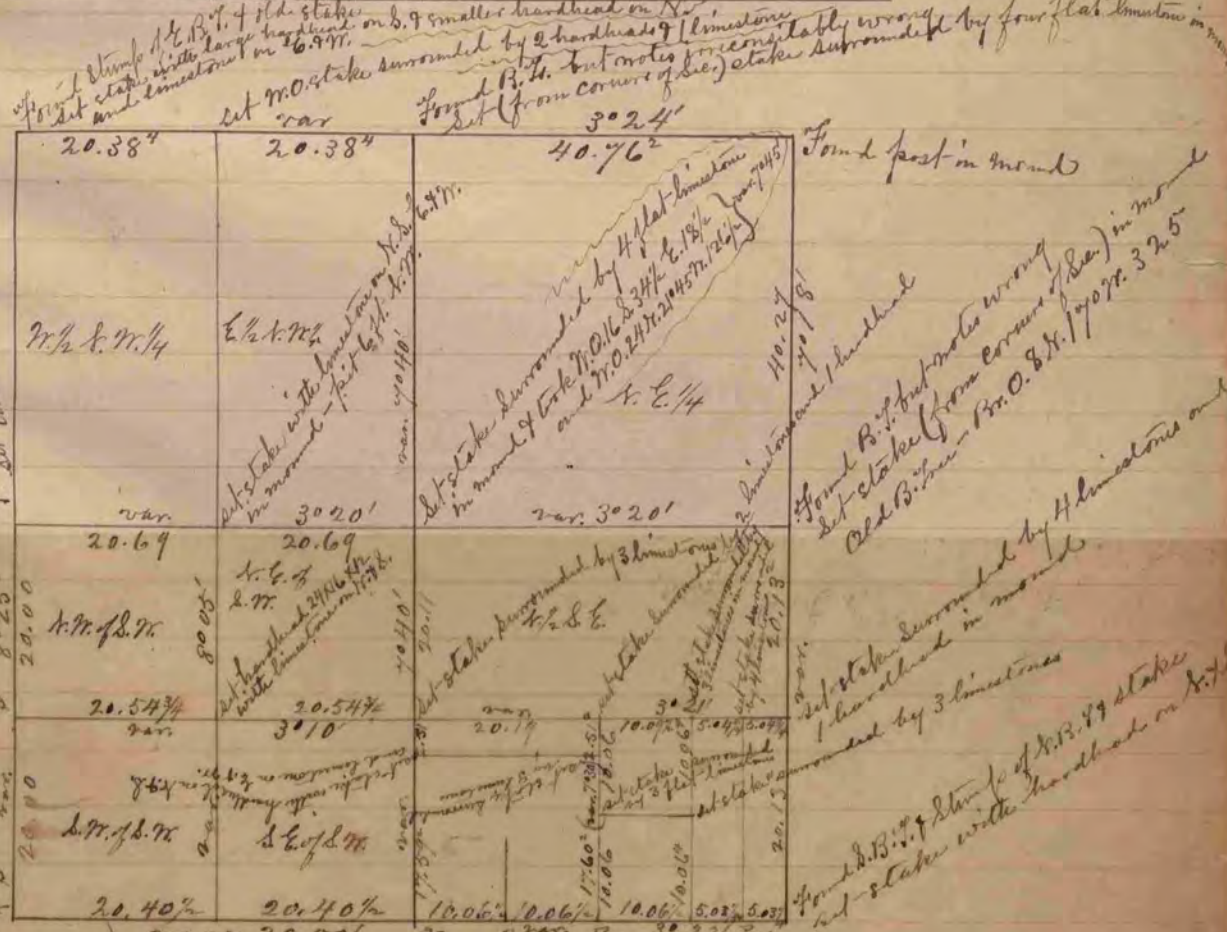

The above is a correct Record  
Plat of a Survey made by me  
May 7, 8, 14 + 15, 1867, on Section  
12, Springville,  
S. D. Locke County Surveyor for Rock Co. Miss.