


A Record and plat of a survey made on Sec four Town
two Range ten East

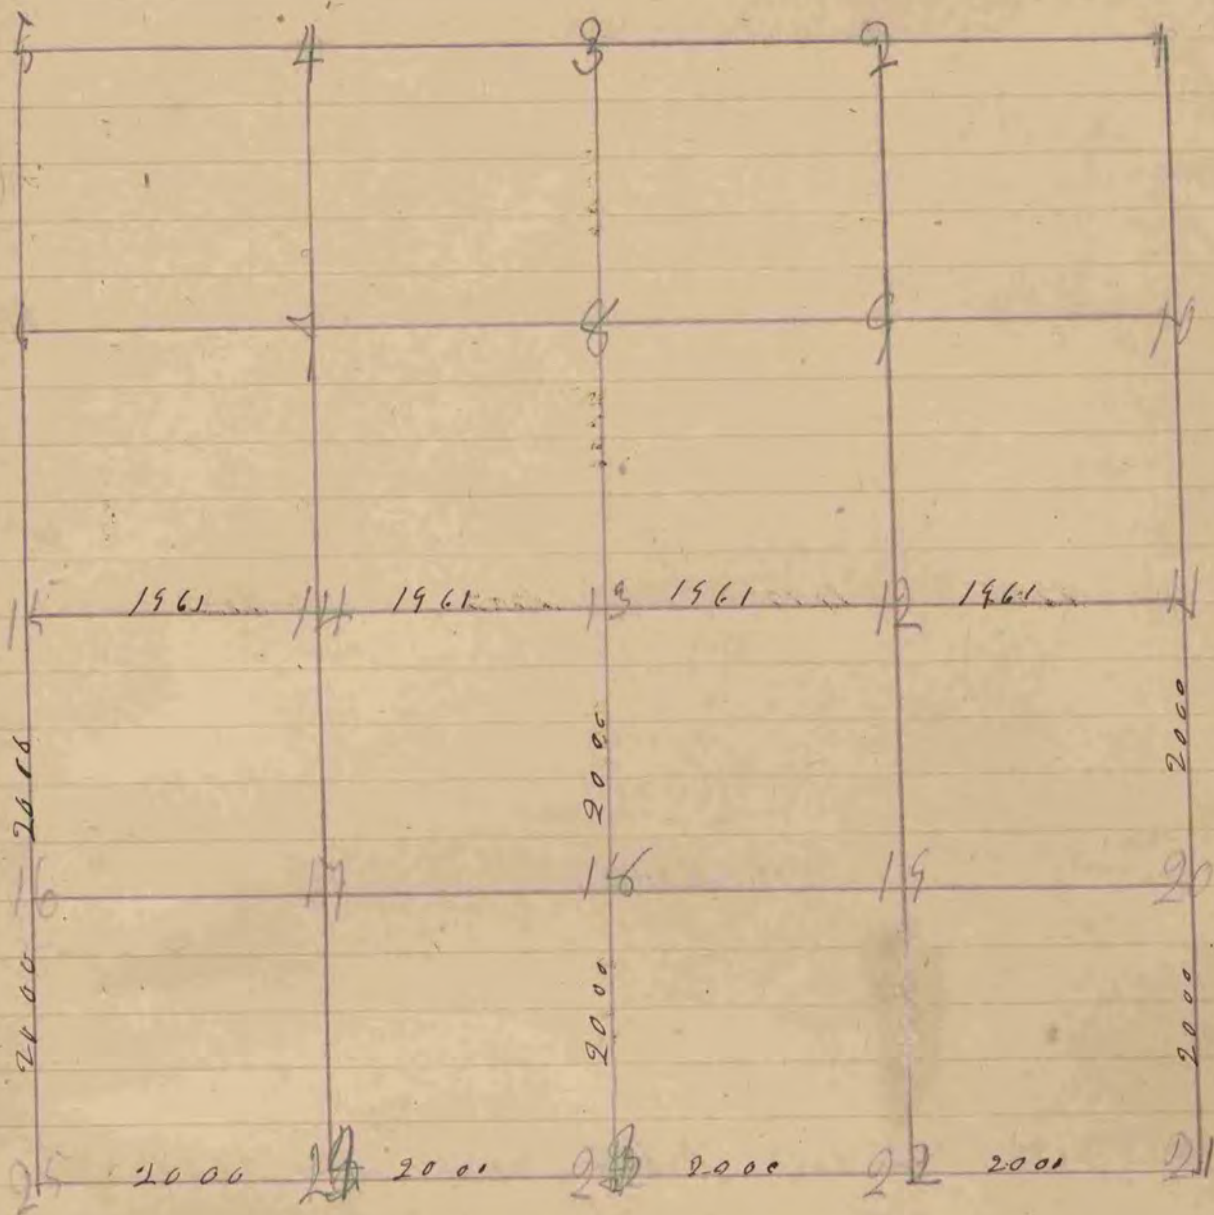

- Fig 21 S E Corner of a well at 1/4 W 102 links
 S W - of a Store house S 68 1/4 D W 200 links
 = 12 Bur Oak S 65 1/4 W 57 links
 = - S 69 1/2 E 56 =
 13 Black O 14 N 34 W 667 =
 Bur O 14 S 51 1/2 E 121
 23 the government survey is at 46 E 87 from where
 it should be
 - Bur O 20 S 25 1/2 E 34 1/2 links
 20 at 14 W 78 =

The above survey was made June 5th 1855

Joseph Church County
Surveyor

Spring Valley