


The above is a record and plot of a survey made by me on the South-East quarter of section 22 Jansenville April 15 - 1875
 Edward Ruyter
 County Surveyor

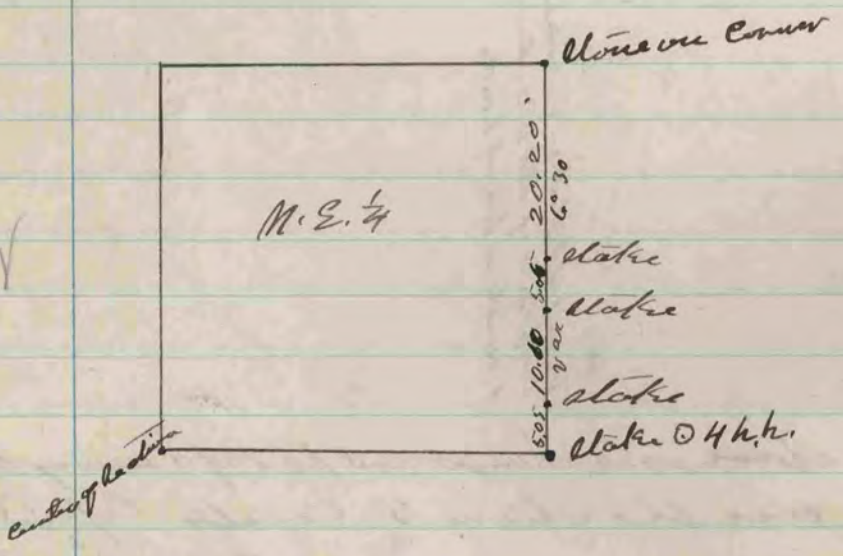

COUNTY SURVEYOR
 RECORD 2 1869-1900

The above is a record and plot of a survey made by me on the N. E. 1/4 of sec. 22 Jansenville - Dec. 13, 1875
 Edward Ruyter
 County Surveyor