


The above is a record and plat of a Survey made by me May 3rd 1881 on Section 33 Jansville.
R. K. Lee
Co. Surveyor

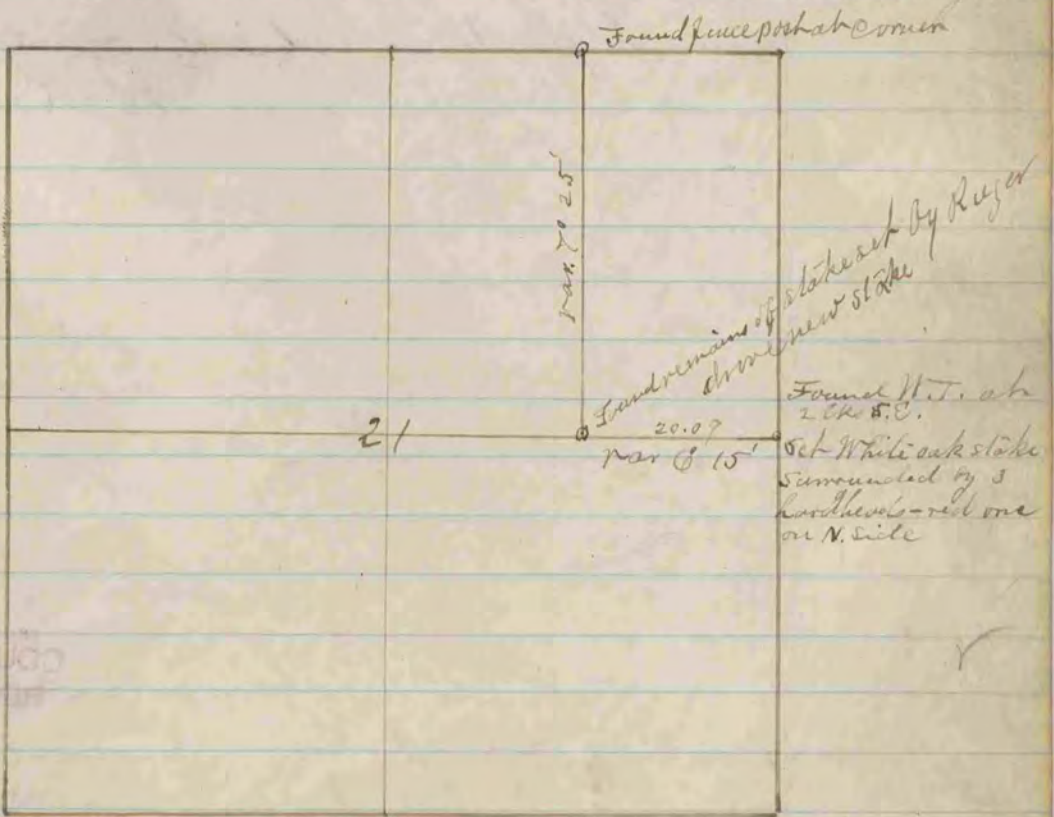

The above is a record and plat of a Survey made by me May 6th 1881 on Section 21 Jansville.
R. K. Lee
Co. Surveyor