


The above is a record and plat of a survey made by me
November 26th & 27th 1853 on Section 31, Fulton.

R. K. Lee Dep't. Co. Surveyor.

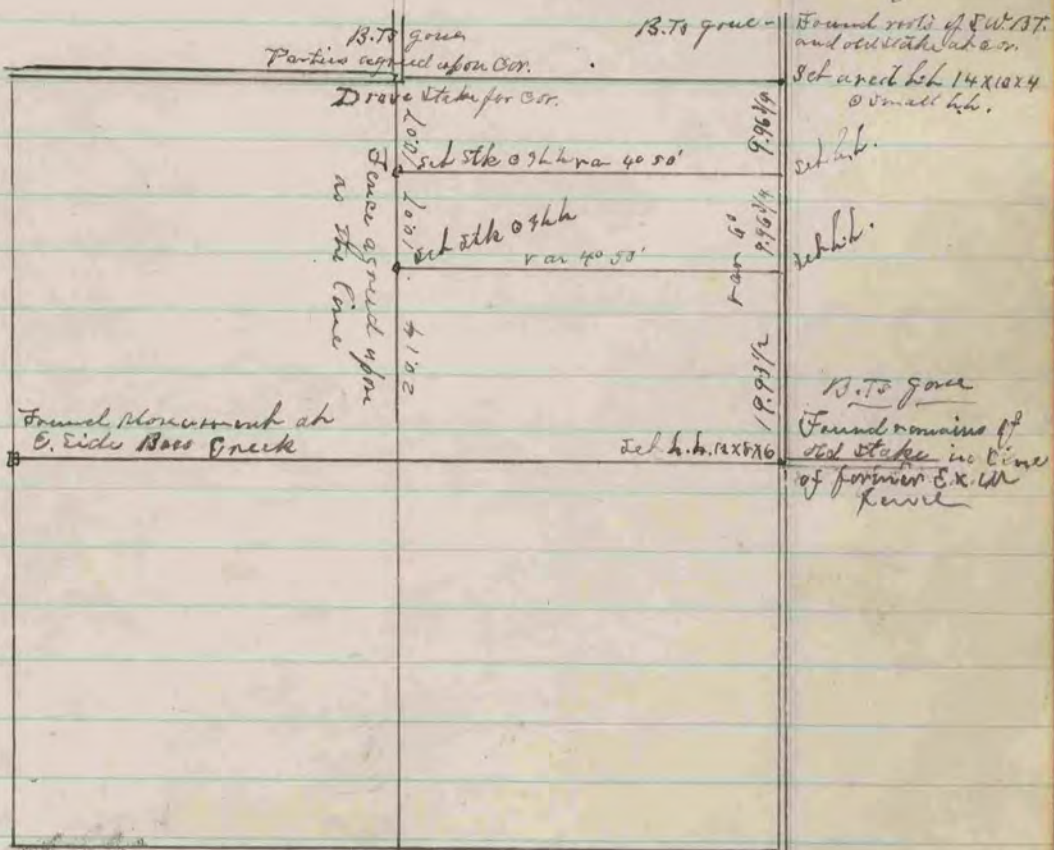

The above is a record and plat of a survey made by me
Dec 2nd & 9th 1853 on Section 19 Rock

R. K. Lee Dep't. Co. Sur.