


17-70

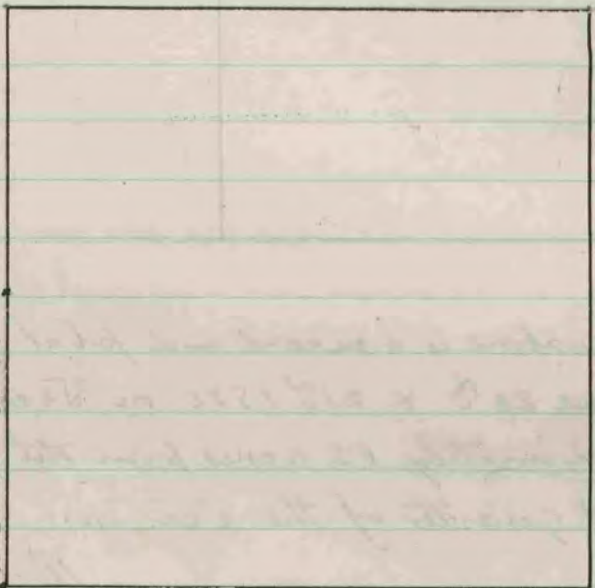

Found stumps of both R.T.s
& place discolored in ground
drive stake & surrounded by 3
hard headstones.

40.09

Found remains of old stake &
where stumps of N.W. & N.E. R.T.s
had been dug up. Set in place
of old stake limestone 17x9x3 1/2
& surrounded by 4 hard headstones.

The above is a record & plat of a survey made by me on
Section 34 Clinton Sept. 26. 1884.

Edward Rugges
County Surveyor