


The above is a record and plat of a survey made by me on Sect. 32 Union, Sept., 28, 1900

P. F. Brown

Co. Surv.

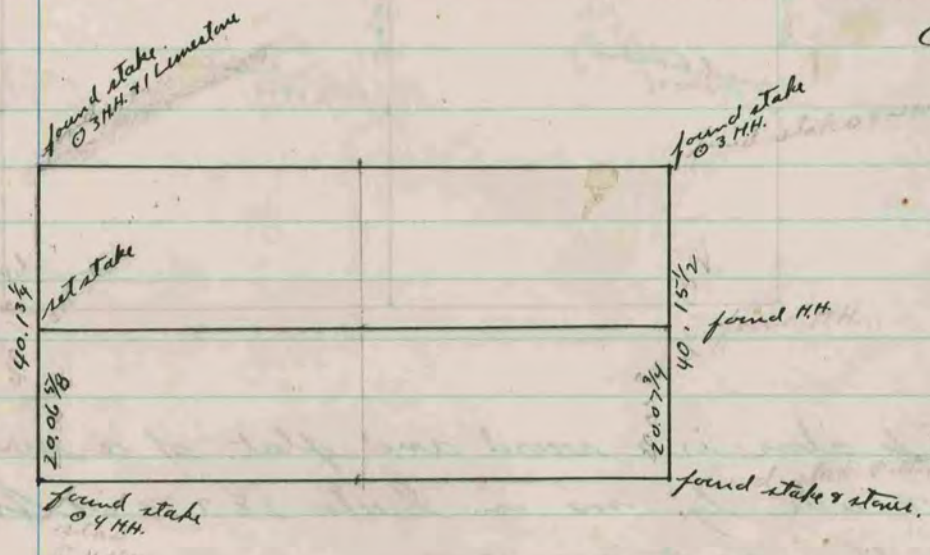

The above is a record and plat of a survey made by me on the south half of Sect 21 Lima, Oct. 1, 1900

P. F. Brown

Co. Surv.

COUNTY SURVEYOR  
RECORD 2 1869-1900