


14-9
- see page 13 - canvas foot.

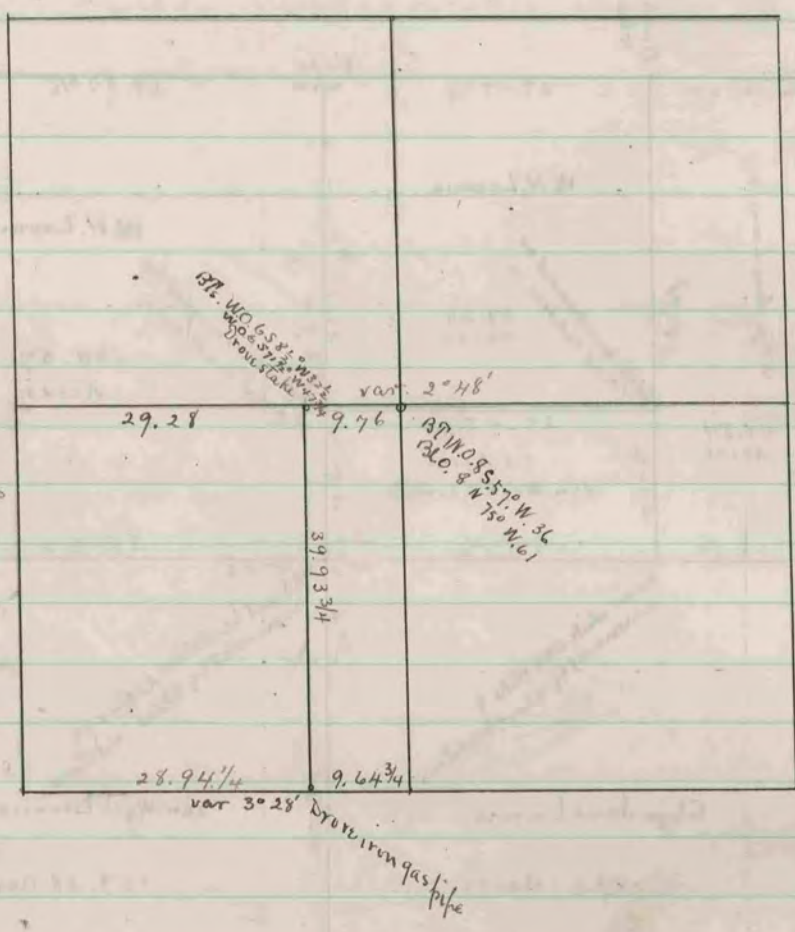

The above is a record & plat of a survey made by me on
Sec 22. Johnston, May 6. 1884.

Edward Ruyer
County Surveyor