


The above is a record + plat of a survey made by me  
 on section 33, Union Oct 22, 1891  
 O. G. Bleedorn, County Surveyor

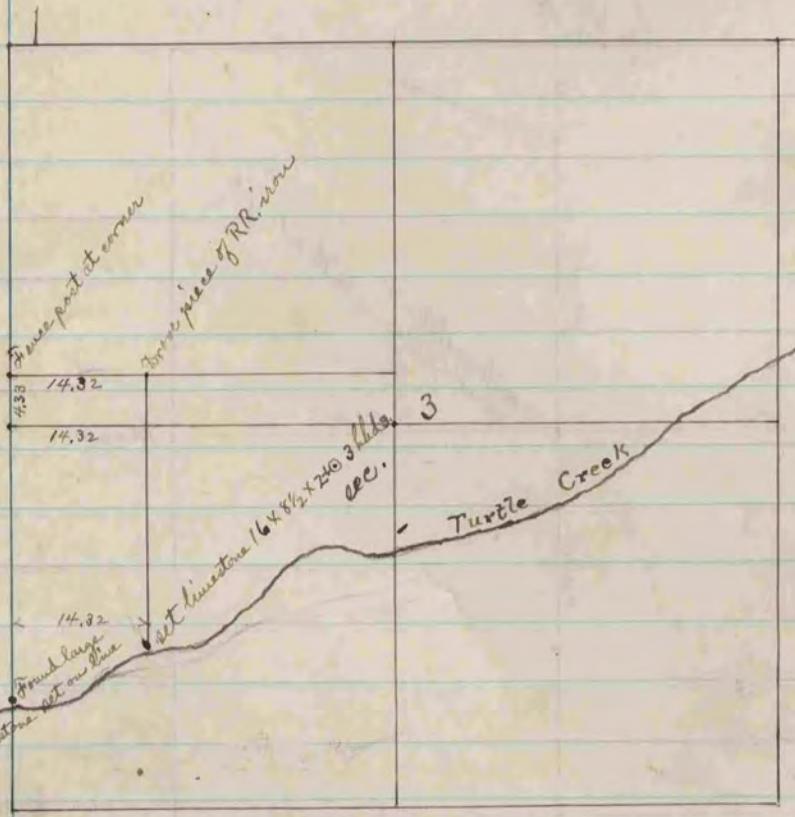

The above is a record + plat of a survey made  
 by me on section 3, Turtle, Nov 23 + 24, 1891.  
 O. G. Bleedorn,  
 County Surveyor