


77-96

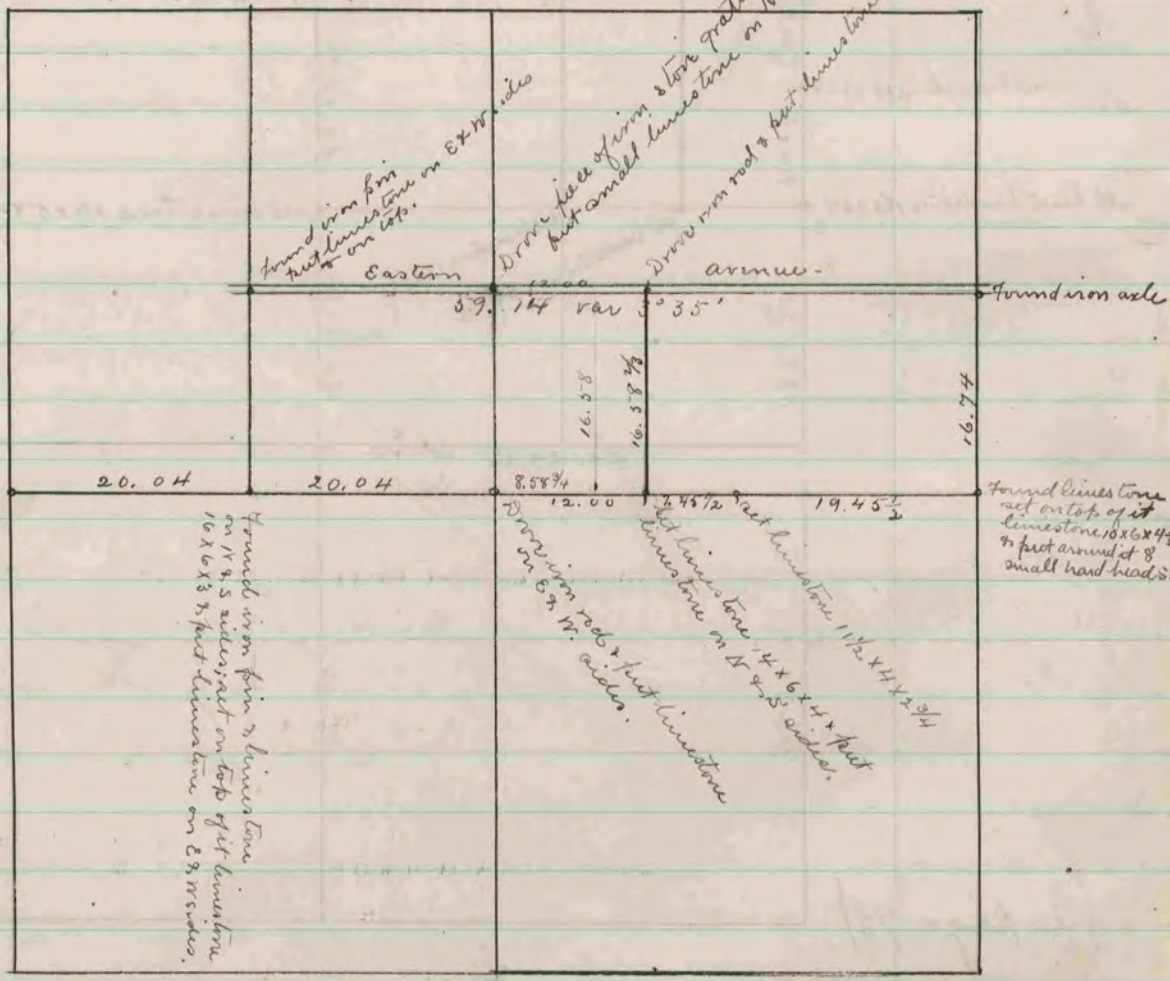

(See page 27)

The above is a record & plat of a survey made by me on Section 1. Rock, June 12, 1882.

Edward Ruyter  
County Surveyor

COUNTY SURVEYOR  
RECORD 2 1869-1900