


K-10

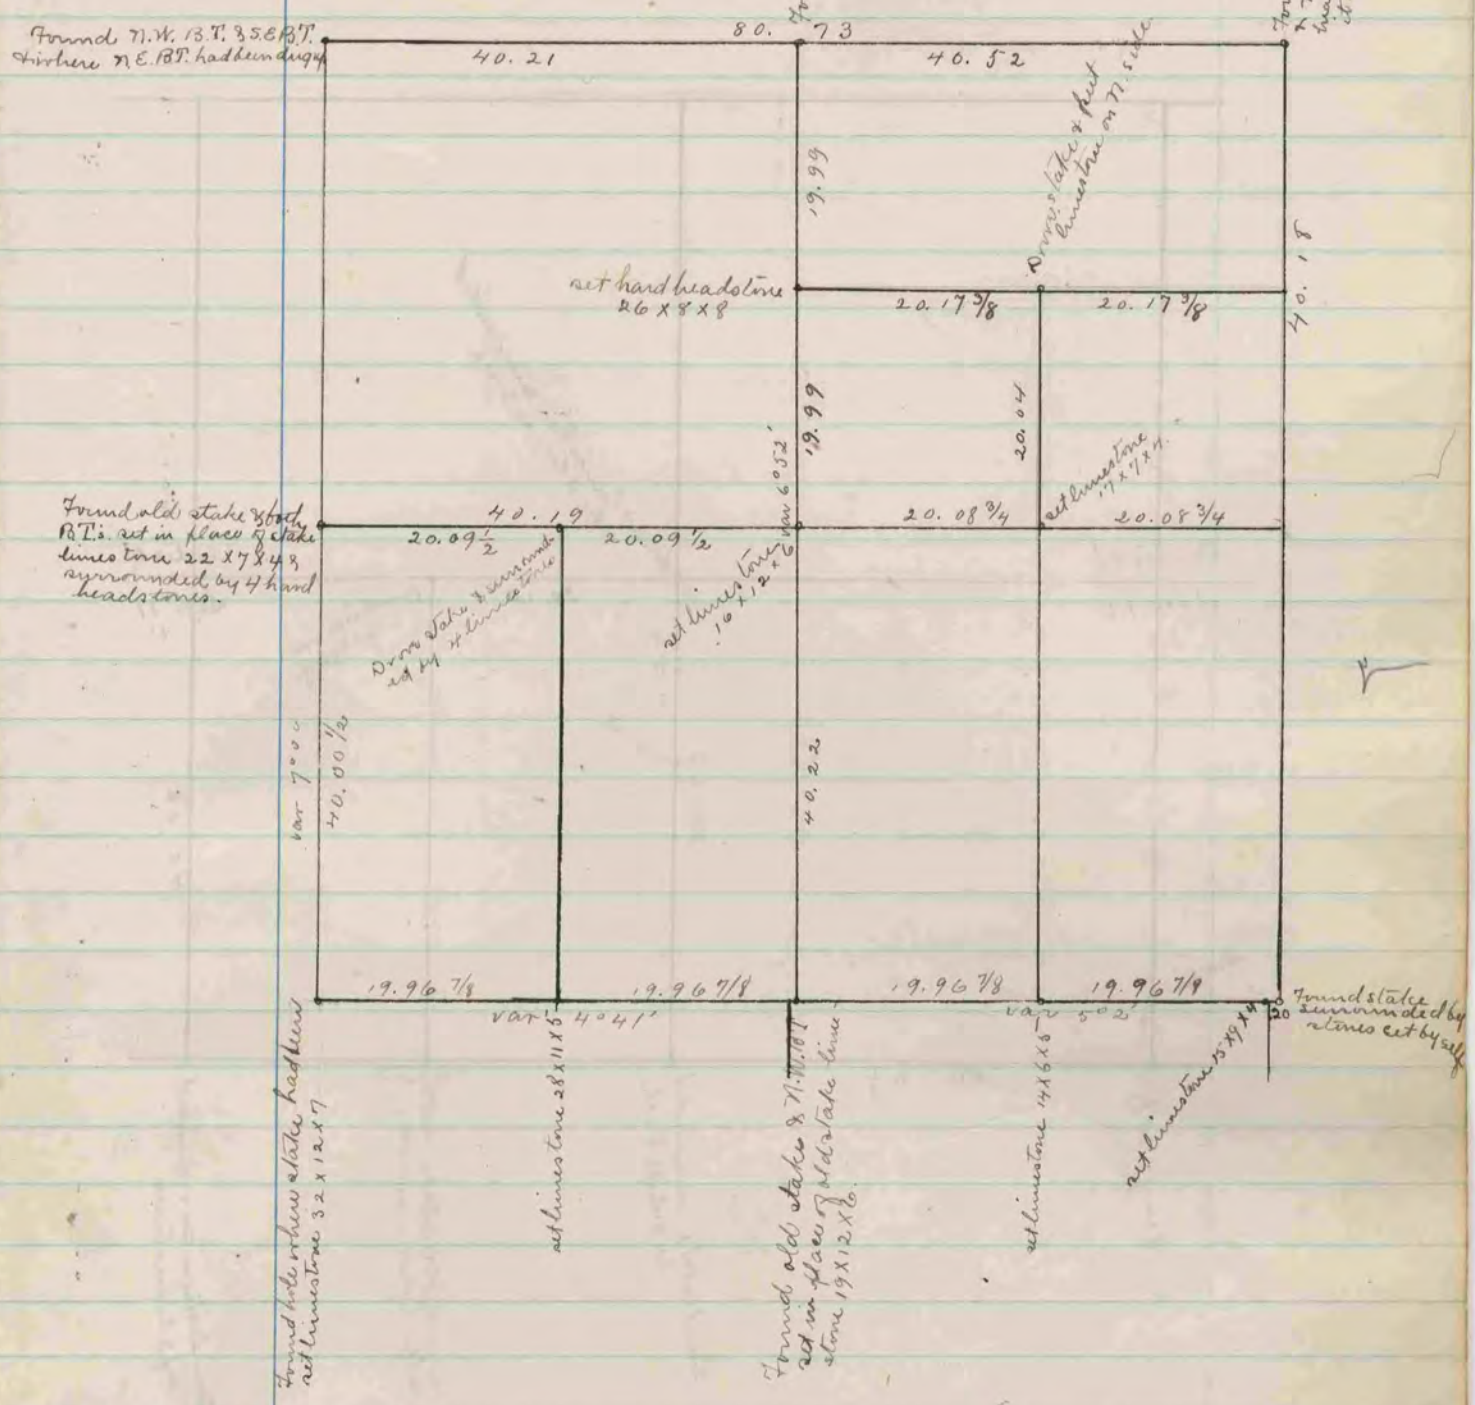

(See page 289)

The above is a record & plat of a survey made by me on Sec. 33, Magnolia, Dec. 14, 1872.

Edward Ruger
County Surveyor

COUNTY SURVEYOR
RECORD 2 1869-1900