


COUNTY SURVEYOR  
RECORD 2 1869-1900

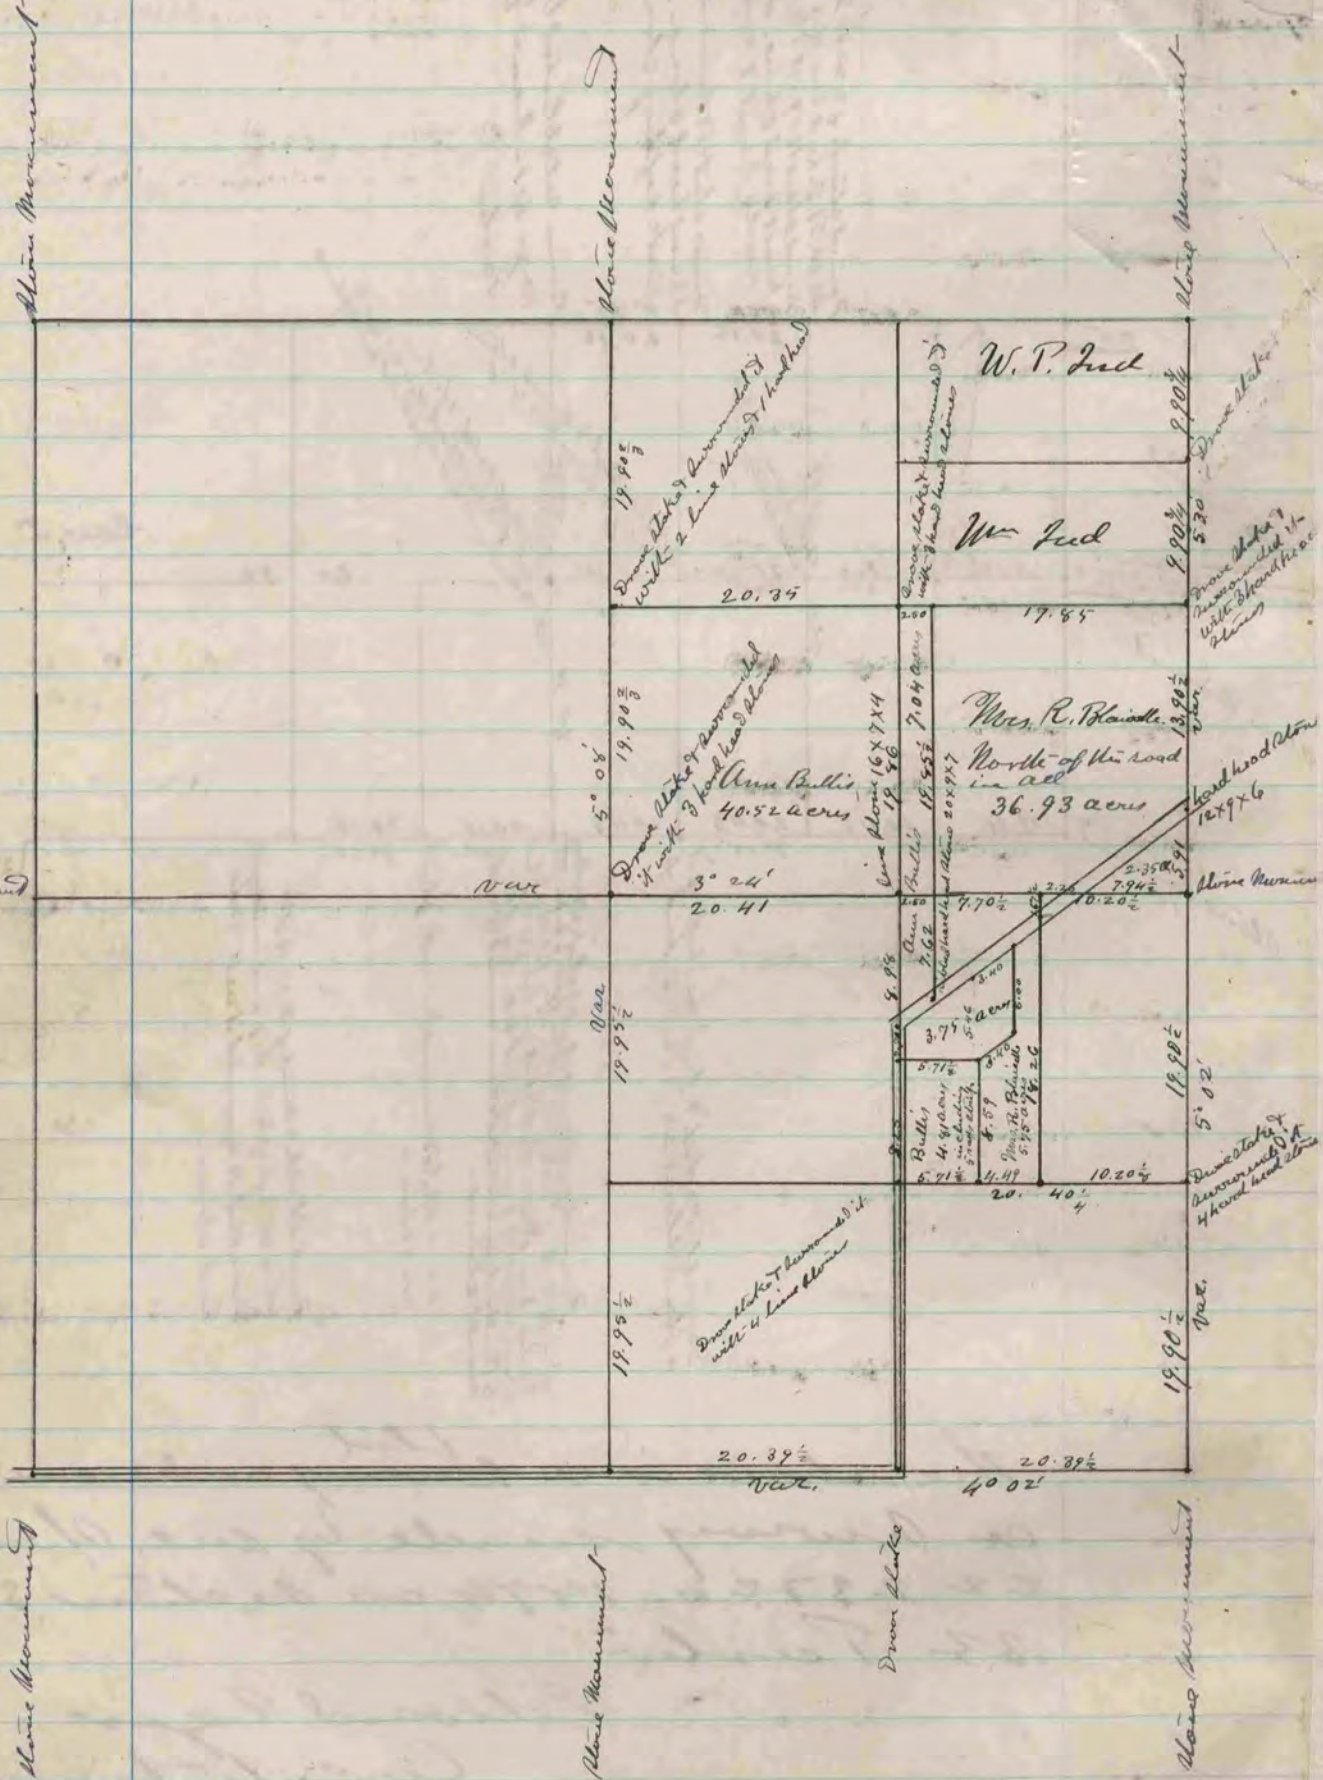

The above is a record and plot of a survey  
made by me on section 2 & 3 Milton.  
Aug. 4. 1876 - 1874

Edward Purget  
County Surveyor