



COUNTY SURVEYOR  
RECORD 2 1891-1900

Found old stake & N.W. bearing true & stump of S.W. bearing true -

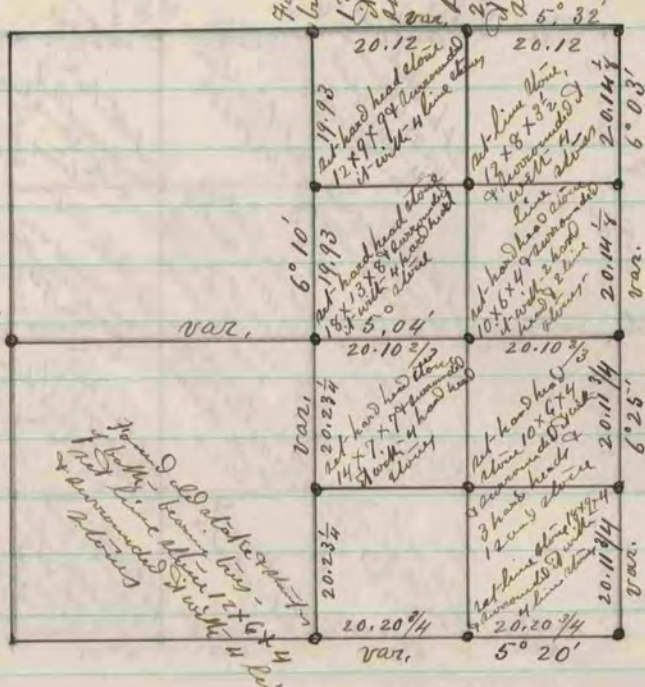

The above is a plot & record of a survey made by me, Dec. 3, 1870 on section 23 above  
Edward Ringer  
Deft. Co. Surveyor

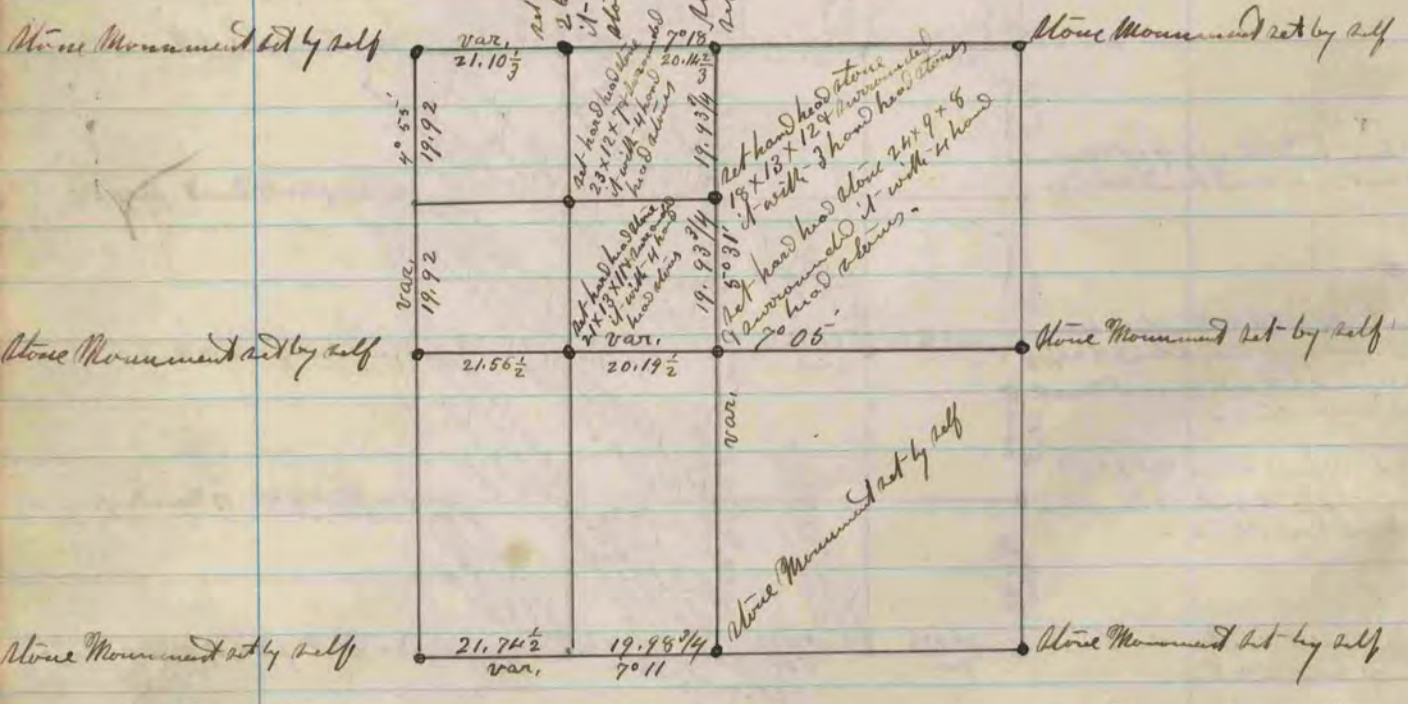

Plot & record of a survey made by me, Dec 20, 21 & 22  
1870, on section 7 above -  
Edward Ringer  
Deft. Co. Surveyor