


See page 54

The above is a plat & record of a survey made by me
 on SE 1/4 Sec. 9, Fulton. July 10, 1908 & May 15, 1891
 O. Bledorn
 Co. Surveyor

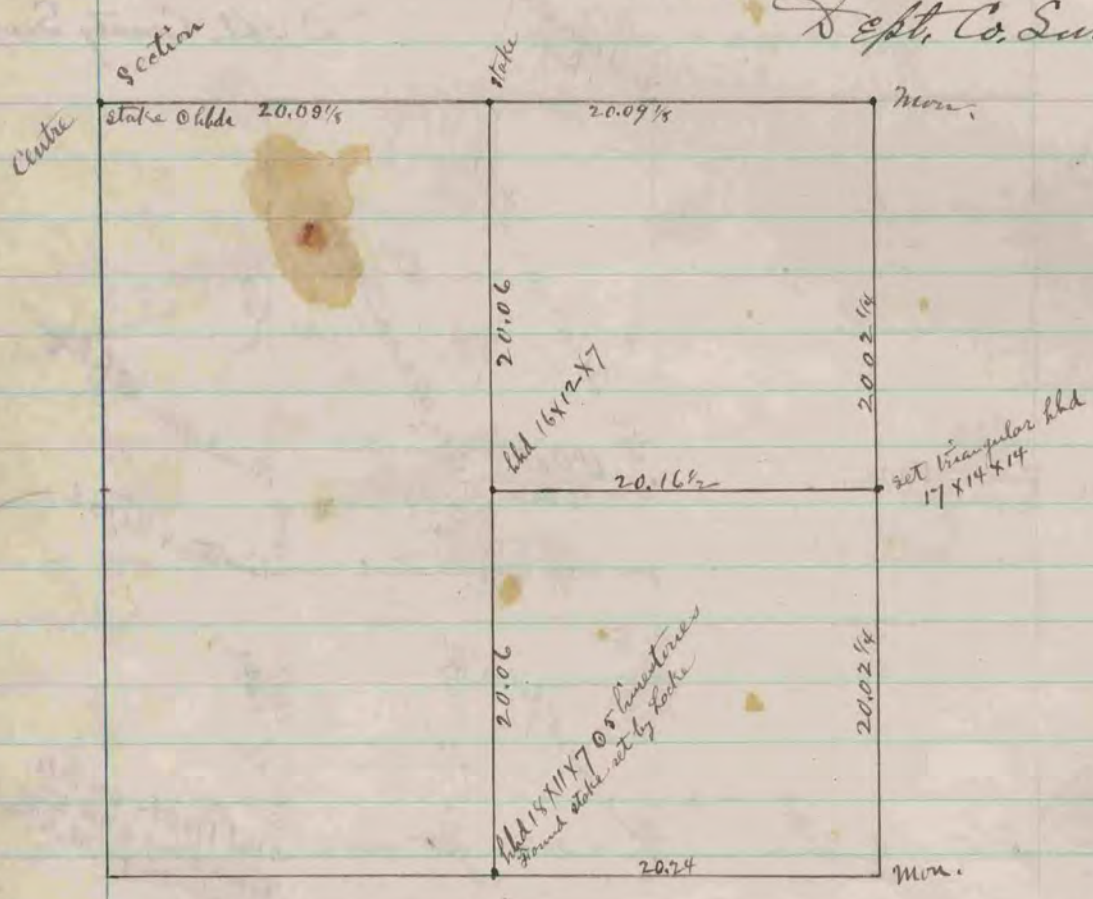

The above is a plat & record of a survey made
 by me on SE 1/4 Sec. 10 Harmony Nov. 5 1890
 O. Bledorn
 County Surveyor