



sec 14 Bradford

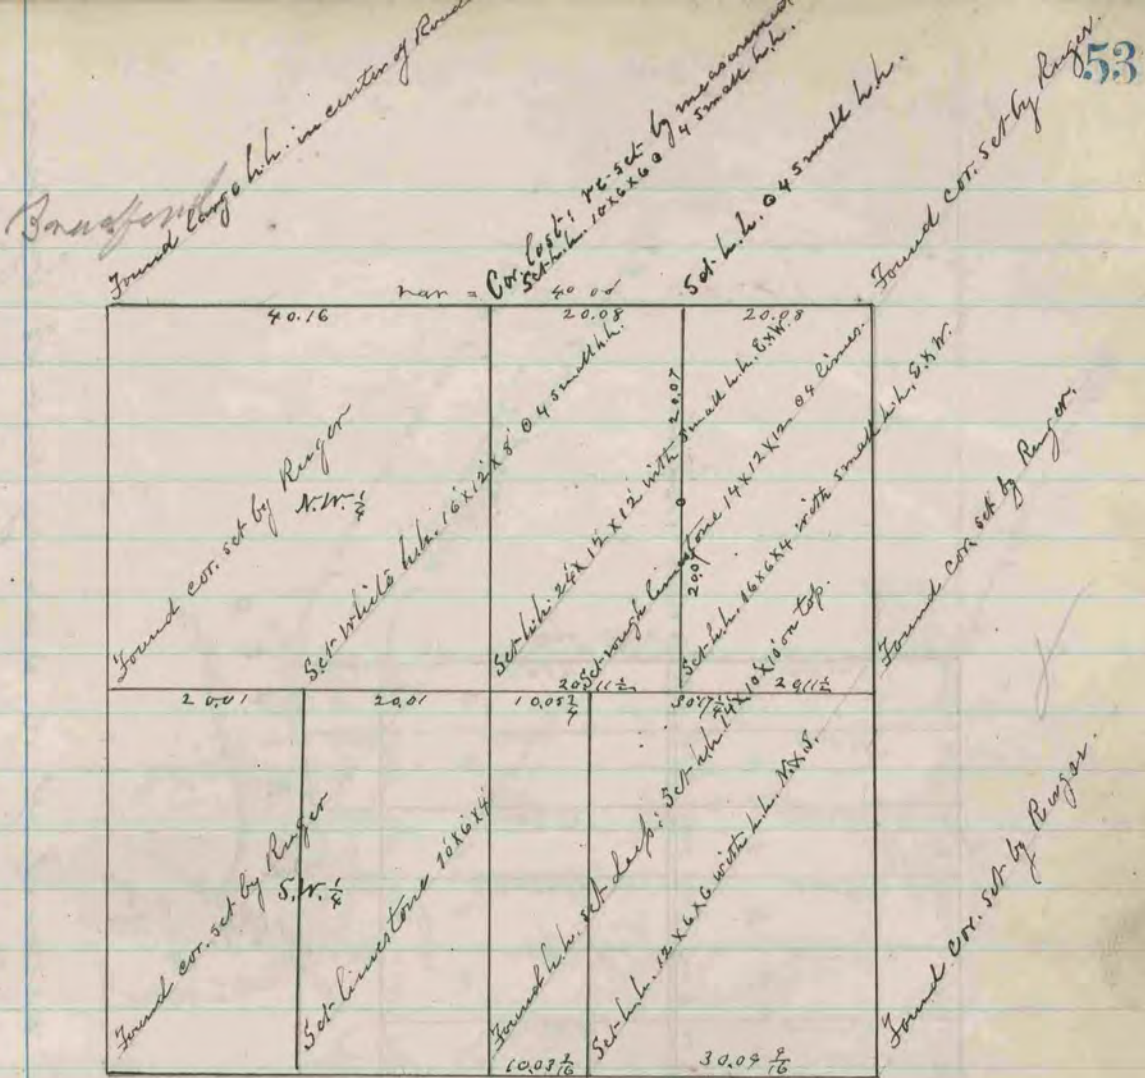

The above is a plat and record of a survey made by me on Section 14 Bradford June 13/1872

R. K. Lee

Dep. Co. Surveyor

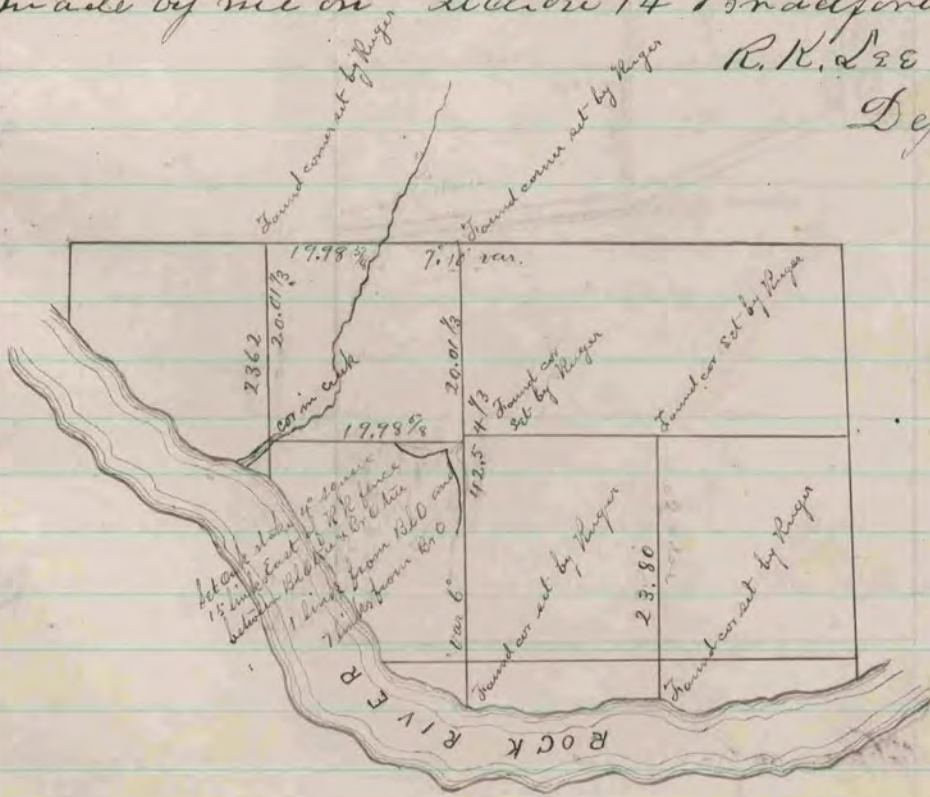

The above is a plat and record of a survey made by me on Section 15 Fulton Oct. 4th & 5th 1872.

R. K. Lee

Dep. Co. Surveyor