


See page 61

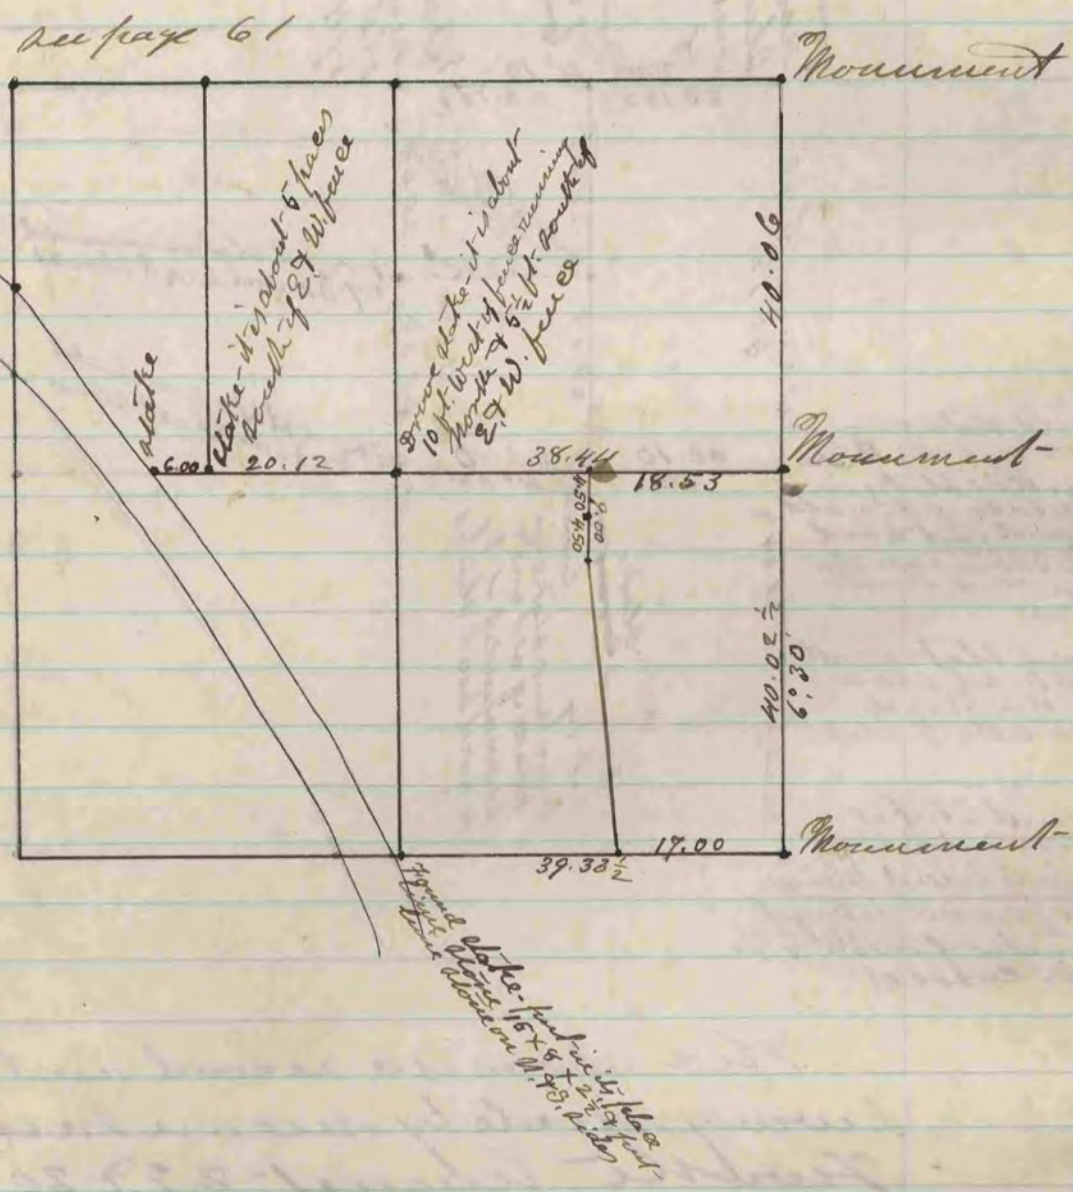

This above is a record and plat of a survey made by me on section 36 Rock Sept. 1st 1876

Edward Rayer
County Surveyor

COUNTY SURVEYOR
RECORD 2 1869-1900