


RECORDED & INDEXED
FOR EVANGELINE
COUNTY SURVEYOR
MAY 15 1875

Found old stake and both
bearing true.

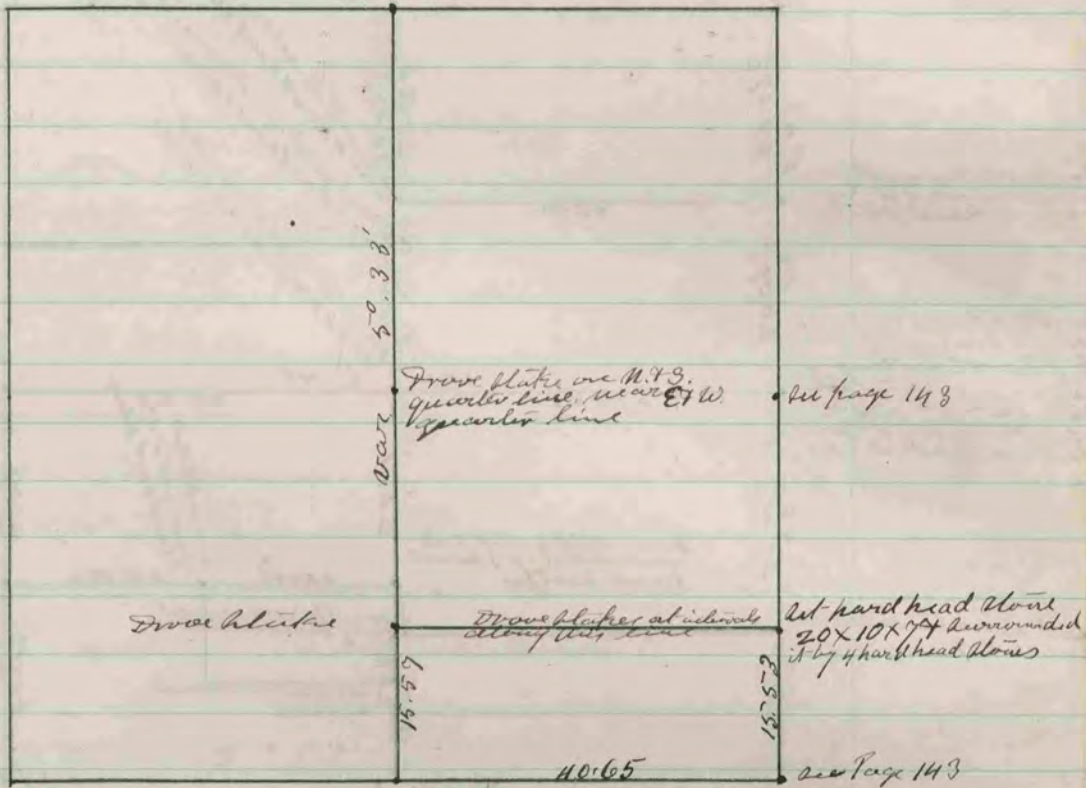

Found old fence post hole
at corner also found
where stump of B. Y.
had been dug out - set
hard head stone 20x10x13

The above is a correct record and plot of
a survey made by me on section 34
T. 11 N. R. 15 W. May 15 - 1875
Edward Burger
County Surveyor