


Stake surrounded by 3 hard head stones  
See Book 2 page 143

Stake surrounded by 4 hard head stones  
See Book 2 page 143

Stone 15x7x5  
surrounded by 4 red  
bricks

Black Oak tree 7  
inches in diameter  
marked with 3 nails  
on each of the 4  
sides - See Book 2  
page 143

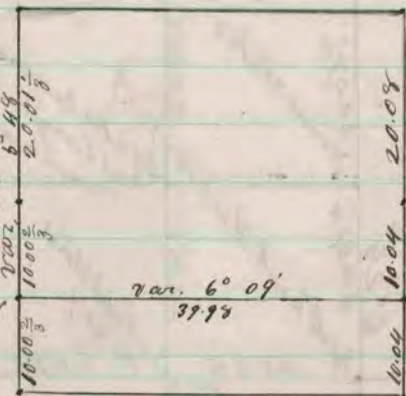

Stake surrounded by 4 hard head  
stones in round pit - 4 ft. apart  
See Book 1 page

Stake with hard head stones  
on the north and south  
sides of stake

Stake surrounded by 3 hard  
head stones

Stake surrounded by 4 hard  
head stones see Book 1  
page

The above is a correct record and  
plot of a survey made by me on the  
south west quarter of section 36  
Town of Fulton May 28, 1875

Edward Rieger  
County Surveyor

At the intersection of the center line of the river road on the east  
bank of Rock River, with the south line of Sec. 14 Rock bet limestone  
14x5x4 feet small hard head stones on N & S sides - The corner is  
43 1/3 links east of the Meander corner - At the Meander corner on  
the east bank of Rock River, on the line of Sec. 14 Rock  
found remains of old stake & S. E. bearing true, bet limestone  
stone 11x6x3 feet small hard head stones on N & S sides -  
At the angle in the road 3.00 chs. N. 7° 30' E. from south line of said  
Sec. 14, drove stake in center of road & took bearing true.  
Bkt. O. 85 85° 40' E. 73 1/2, Bkt. O. 12 N. 78° 50' E. 77 - also drove stake 50  
links east for east line of road - thence N. 13° E. 21.39 chs. to  
Eldred's fourth line, drove stake in center of road & bet limestone  
stone 10x5x2 1/2, thence continuing same course 2.61 chs. and  
drove stake in center of road -

The above is a record of a survey made by me  
on Sec. 14, Town of Rock, May 26 & 27 - 1875

Edward Rieger  
County Surveyor