


Found remains of old  
at the old corner, also  
found blimp of M.W.  
B.P. 7. I have blimp of  
S.W. B.P. 7. had been dug  
up. - One was at the  
place of old well and  
surrounded it by 1 head  
head of 3 line blimp

Found blimp of S.E.  
B.P. 7. & where blimp of  
M.E. B.P. 7. had been dug up  
did not establish

Found old stake at  
corner - also found  
M.W. B.P. 7 and blimp  
of S.W. B.P. 7. Drove  
stake in place of old  
& surrounded it by 1  
& 3 head blimp

Found blimp of M.E. B.P. 7  
& where blimp of S.W. B.P. 7  
had been dug up. Drove  
stake & surrounded it  
by 4 blimp

Found old stake and blimp  
of both B.P. 7. & 6  
16 +  
5 + 6

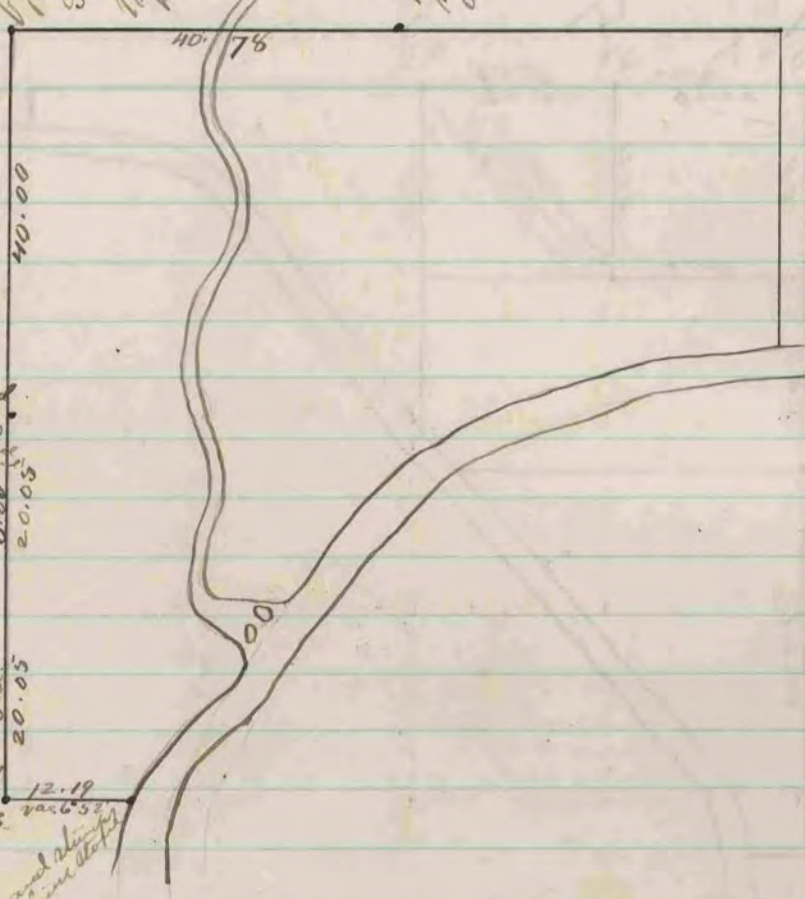

The above is a record and plot of a  
survey made by me on Section 19  
Tulsa - August 18 & 19 - 1875  
Edward Ruyor  
County Surveyor

COUNTY SURVEYOR  
RECORD 2 1869-1900