


COUNTY SURVEYOR
RECORD 1859-1906

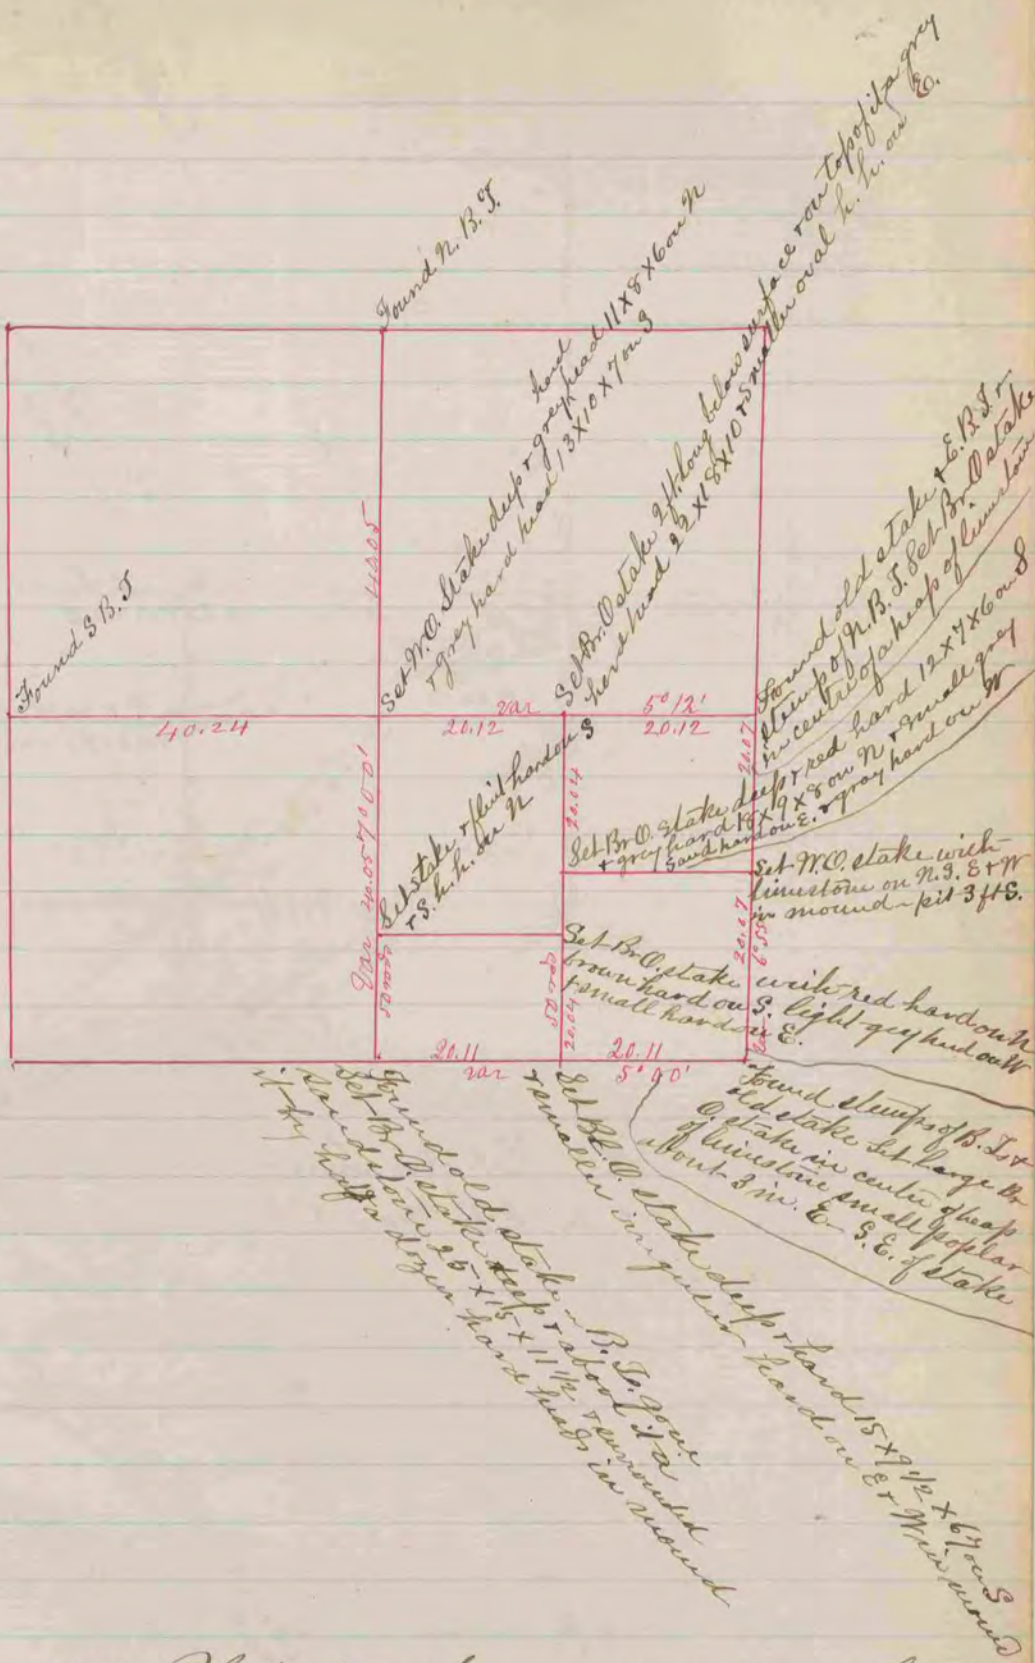

A Record & Plat of a Survey made on Sect 10,
T.1. R. 13 May 17 1864 by S. W. Locke Co. Surveyor
Turtle

RECORDED & INDEXED
MAY 17 1864