


Rec Vol 1 PG 105

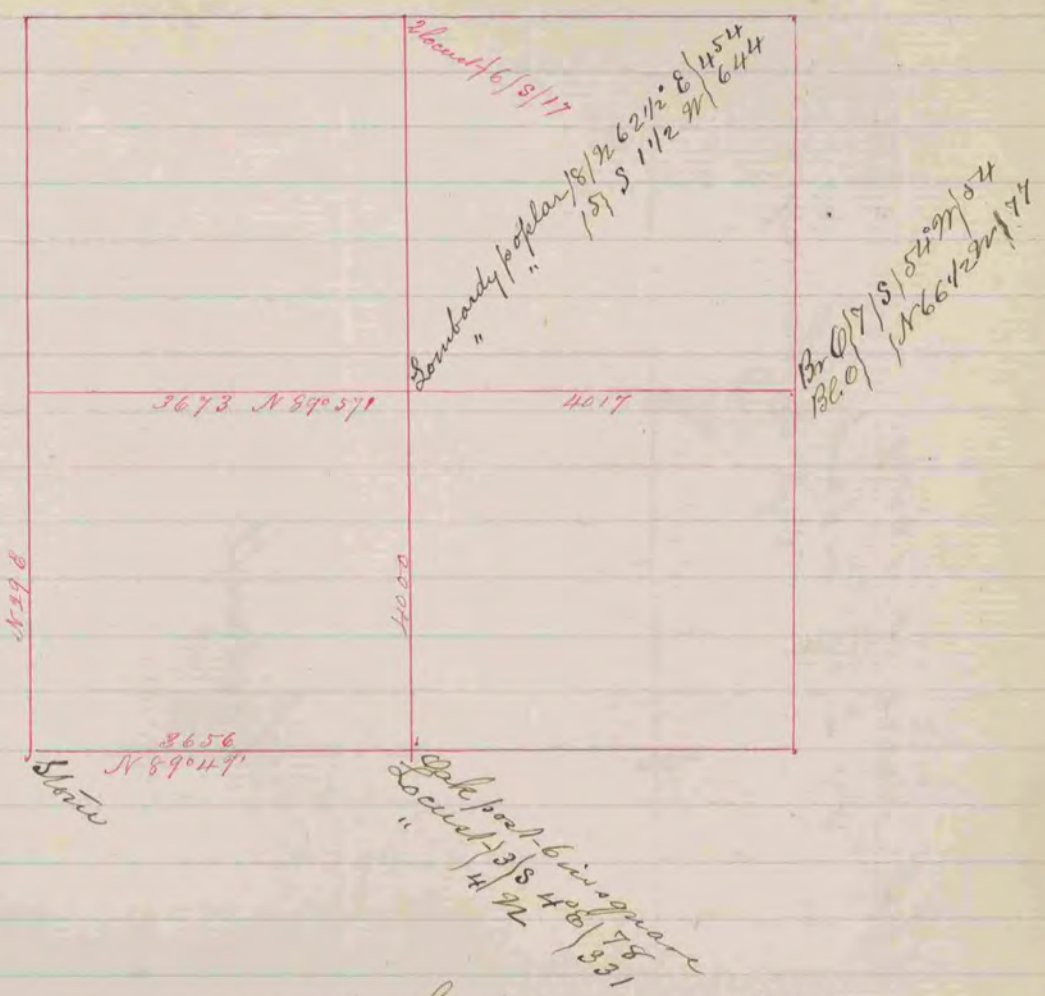

Course according to the true Meridian
Var. 5° 30'

Measurement in fks.

Note of bearing trees established at the time of the survey are given on the plat

A Survey on Sec. 19. T. 1. N. R. 13. E. May 31, 1859
Justo by E. J. Hobart Dep. Co. Survey

COUNTY SURVEYOR
RECORD 1859-1906