

70 A Record & plat of a survey made on
the fifteen town two range ten East.

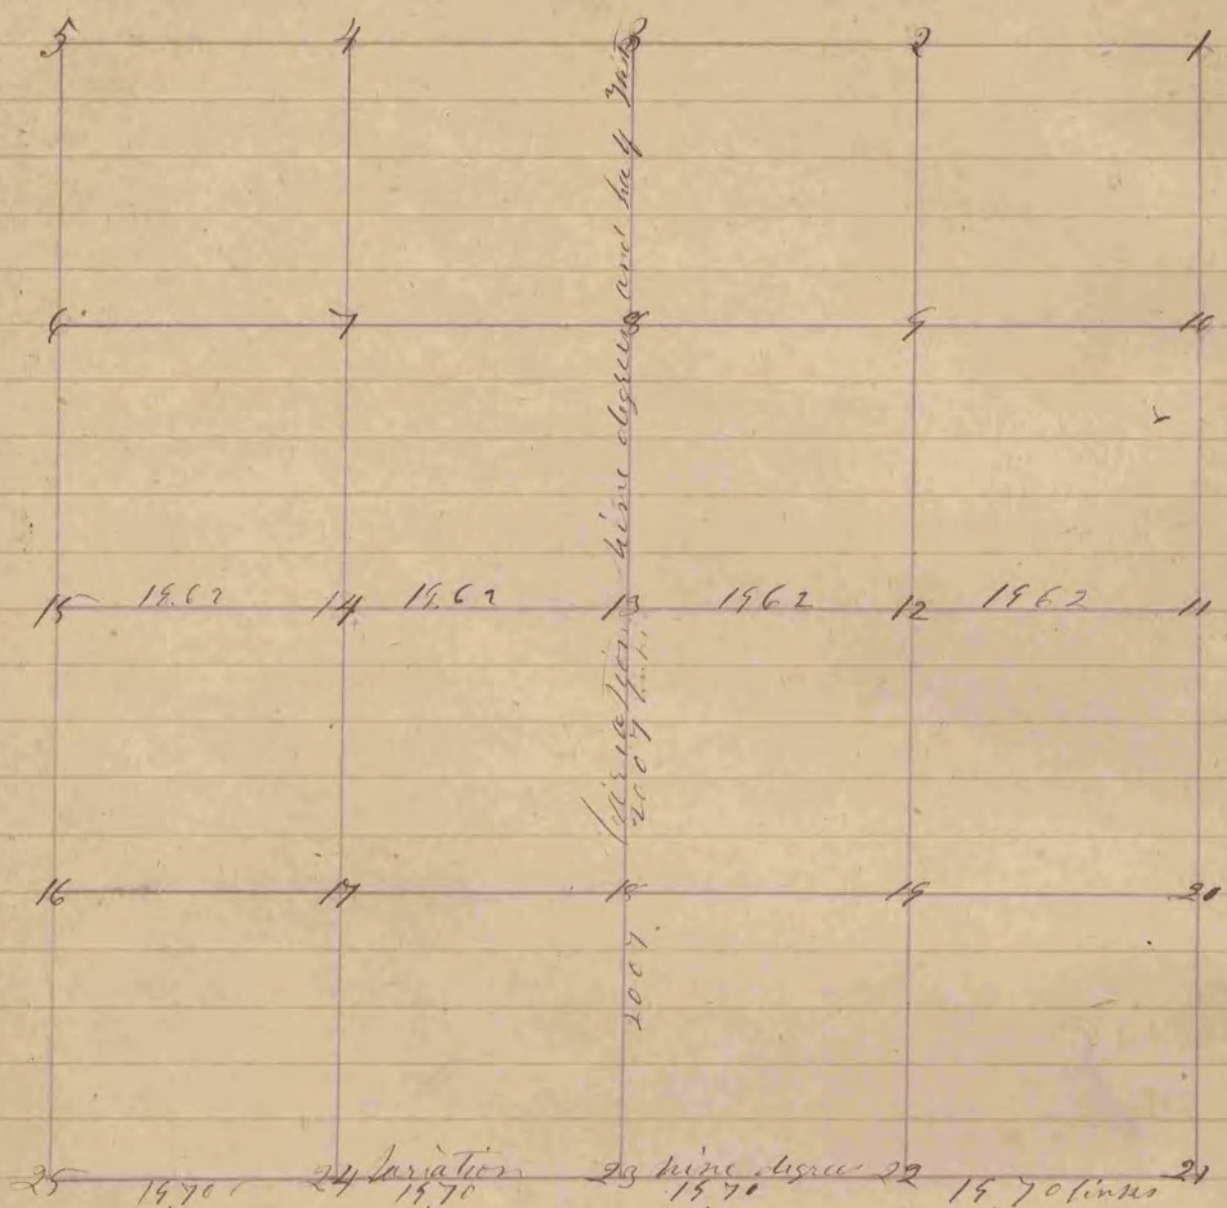


Fig 13 Br C 14 S 44 1/2 W 29 links
 .. 23 N 0 24 S 11 1/4 E 34 ..
 14 N 0 16 S 62 E 16 Variation on the Compuls of nine degrees

Fig twenty three the government trees are not to be found
 and made corners by running the south line and
 placing the stake in the center

The above survey was made on the
 twenty seventh day of March 1857
 Joseph Church County Surveyor
 Rock County Wis