


Record & Plat of a survey made on Sec. 26, T. 3, R. 12 E., by Sylvanus
D. Locke, County Surveyor for Rock Co. Wis.

Distances given in chart
variations marked on line

Louvissville

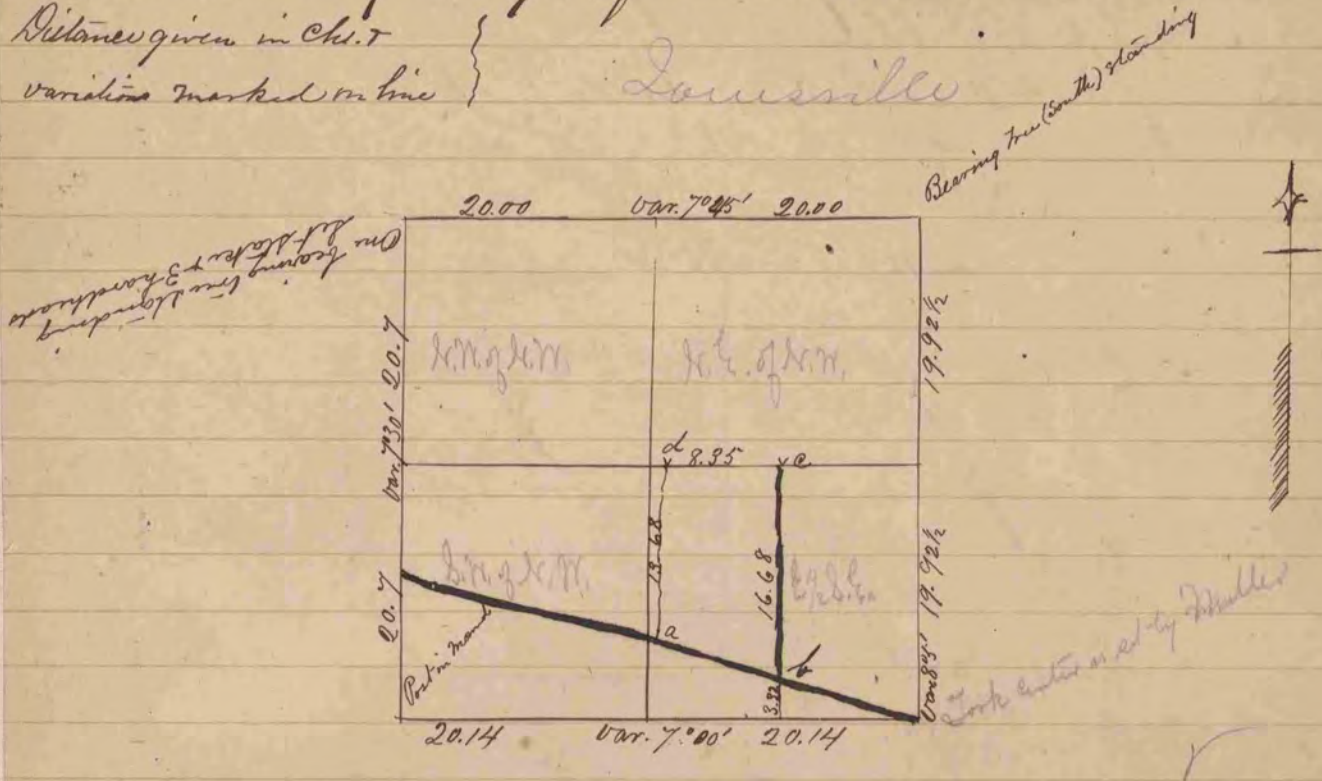

- at "a" set stake & three stones
- " "b" " " "
- " "c" " " "
- " "d" " " "