


A Record and Plat of a survey of a Road running along the North line of Section 15 in Township N. 3 north, of Range N. 12 East of the 4th Principal Meridian said Road is one chain wide lying 50 links on either side of said Sec line for the courses of

Also a Record &
Plat of a Road
Running
Jausillo

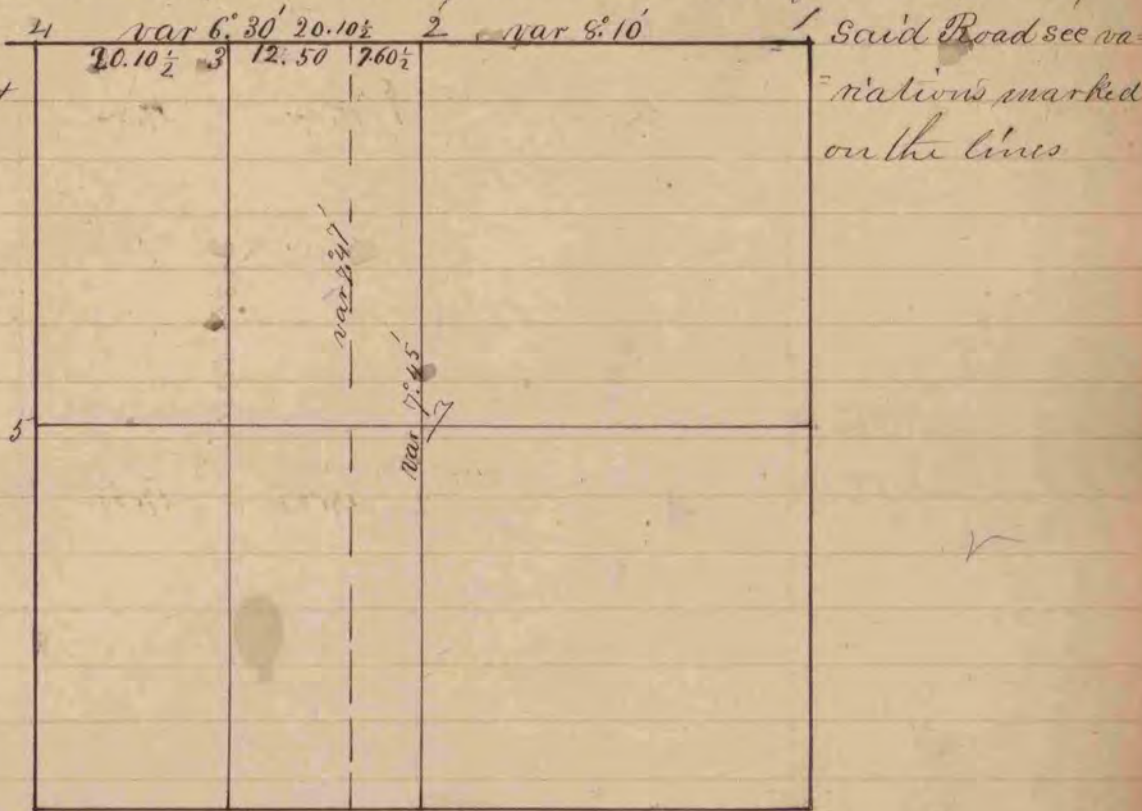

- Fig 1 old witness trees cut down took new one Black Oak ^{var 8:10} N 22 W 36
 Surrounded post by 5 small hard heads
 " 2 put in Post by old witness trees surrounded post by 4 hard heads
 " 3 found post which was correct with stone south
 " 4 put in post by old witness trees
 " 5 old witness trees disagreed put in post by averaging error surrounded post by 4 hard heads
 " 6 put by old witness trees
 " 7 it being only necessary to run the N+S line through the center of the section for the work under consideration did not put in post at center of section

Surveyed April 21st + 22nd 1859
 by Edward Ruger
 County Surveyor of Rock County
 Wisconsin