


Survey on Sec 36 T. 1. R. 13.

Justis

Surveyed June 4th 1859 by  
E. J. Hobart  
Dep. Co. Surveyor

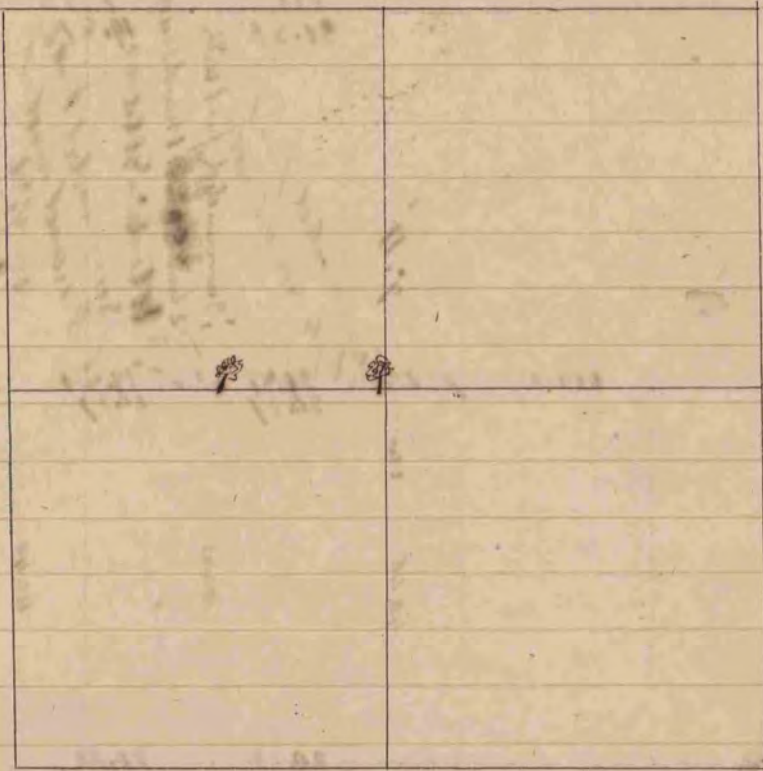

The E & W Cor line at a point 2433 link E of W Cor post  
is 1 foot 3 of center of a br O 16 in diameter  
E & W Cor line at a point 3974 link E of W Cor post  
is 2 1/2 link N of a Br O 16 in diam.