

111

Sec 3 Town 2 Range 12 Rock

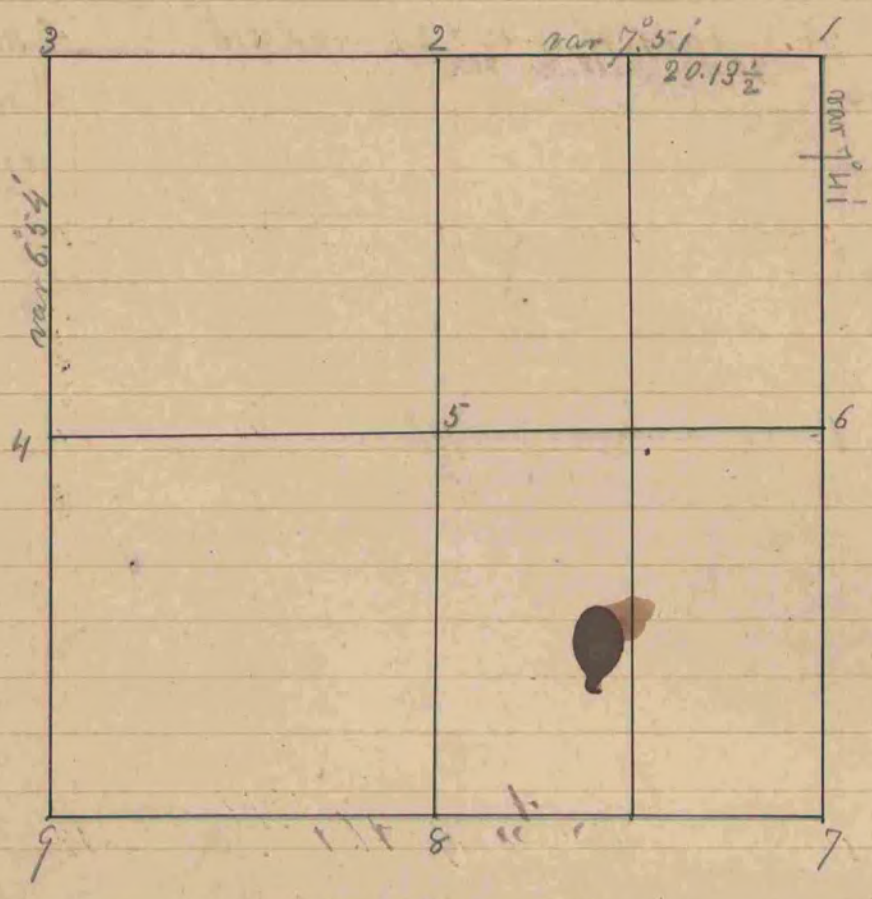


Fig 1 took New Witness Trees  
 Hickory 10 N 39° 25' W 63  
 Hickory 107 S 3° 55' W 36 1/4