


3970

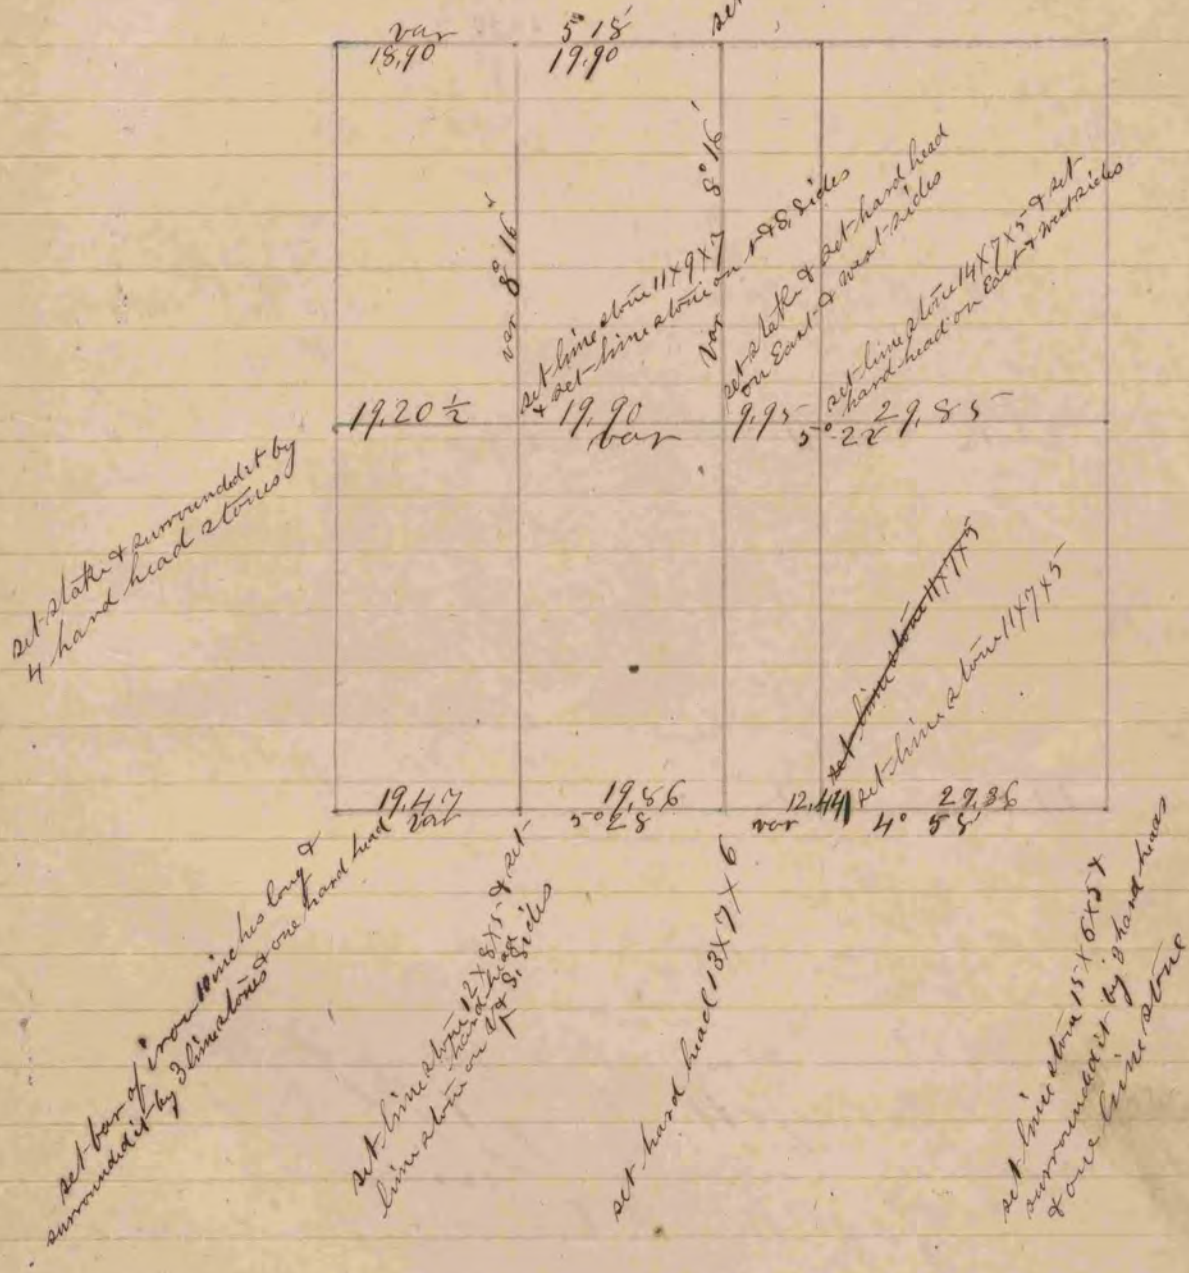

A record and plat of a Survey made on Section 19  
 Town 3 Range 14 June 21<sup>st</sup> 1861 by Edward Ruger  
 County Surveyor for  
 Johnston  
 Rock County Wis

39.72  
 39.80

COUNTY SURVEYOR  
 RECORD 1 1851-1869