

A Record of a Survey made on Section 32 In the Town of Centre

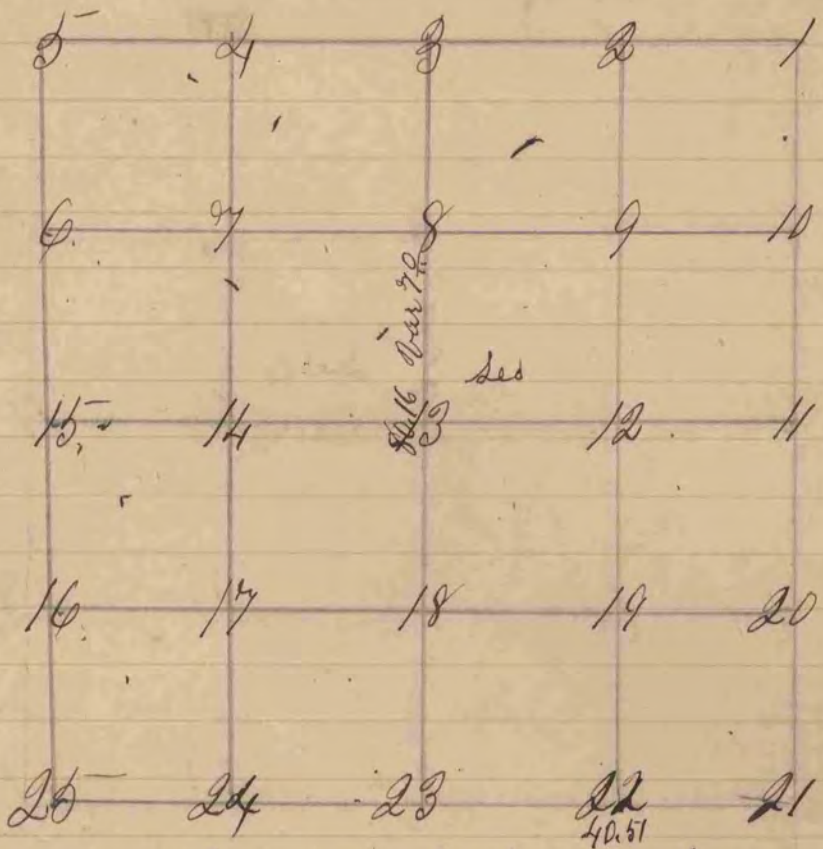


Figure 13 Represents the centre of the section
 fig 13. N 20 1/4 S 25 W 76 also N 20 8 S 74 E 76
 " 24 Br 0 9 S 34 E 70 also Br 0 14 S 31 W 79
 " 12 Post in Grubs

The above Survey was made February 22^d 1853
 Peter McBean County Surveyor