


68 A Record & plat of a survey made on Sec Eighteen  
Town Two Range Eleven East

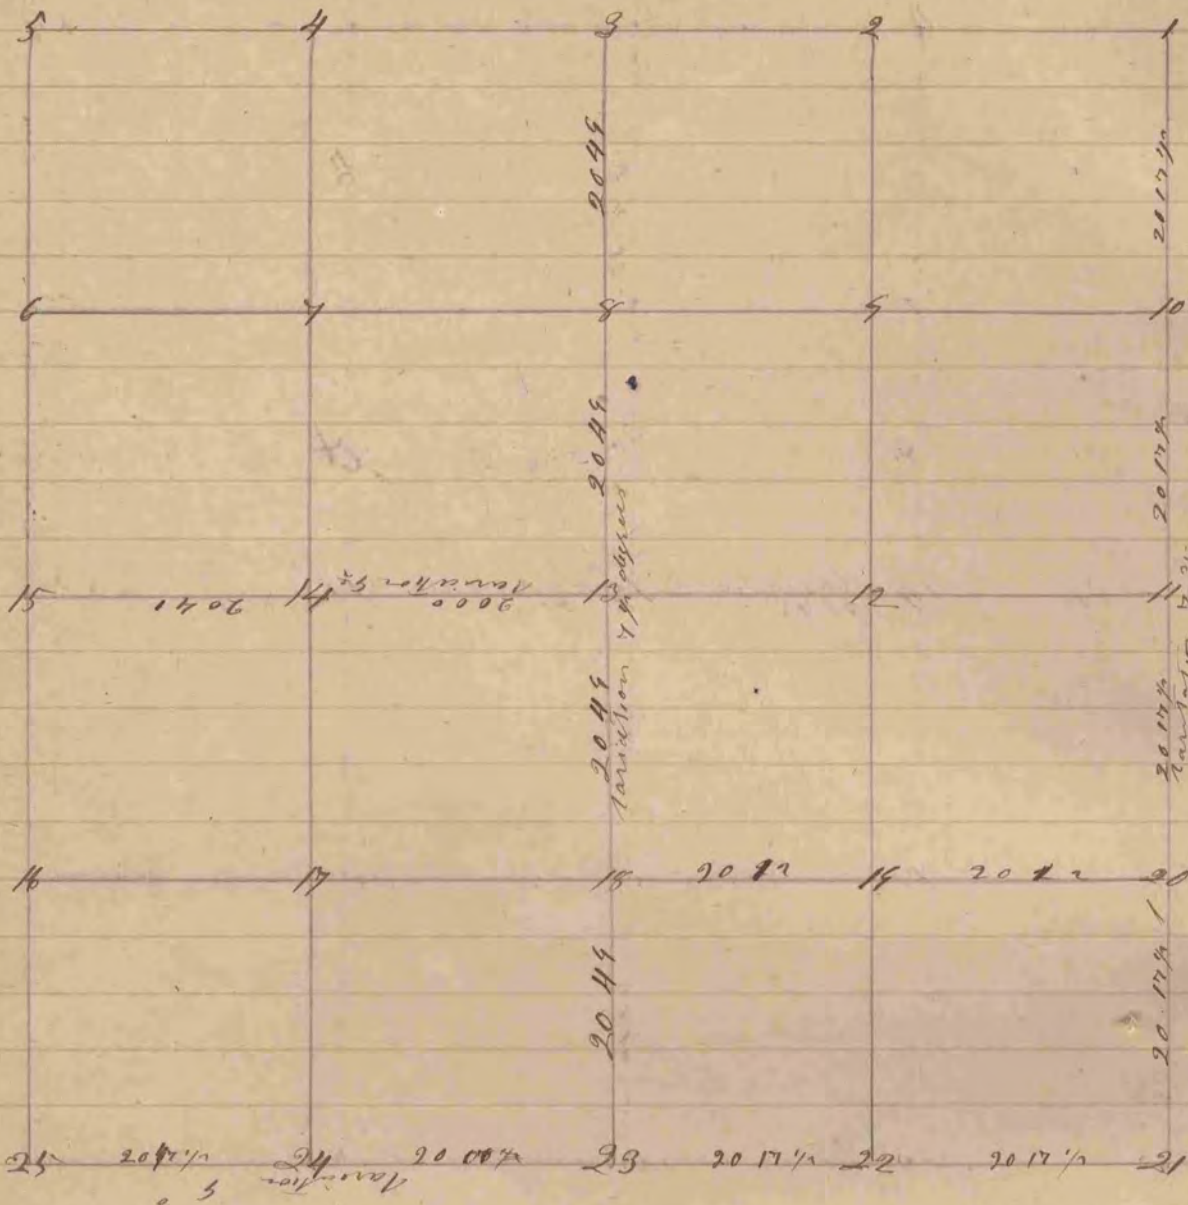

- Fig 13 Stake & Stone in corner  
8 Stake " "  
3 " "  
2 " "  
19 Stake no bearings  
18 Br O 8 S 47° W 135  
    " 0 12 N 1° W 911

Will be corner 91 links on the line West of Fig 14 Br O 10 S 36° E 24  
    " 1 Br O 14 N 74° E 49

Fig 17 Br O 13 N 58 1/4° E 130  
    " 0 14 N 6° W 167.6 7 1/2 Degrees

The above survey was made March nineteenth 1857  
The above survey was on Joseph Church County  
Plymouth Surveyor Rock County Wis