


at home and plot of a survey made on the sixteen  
town four Kingston East

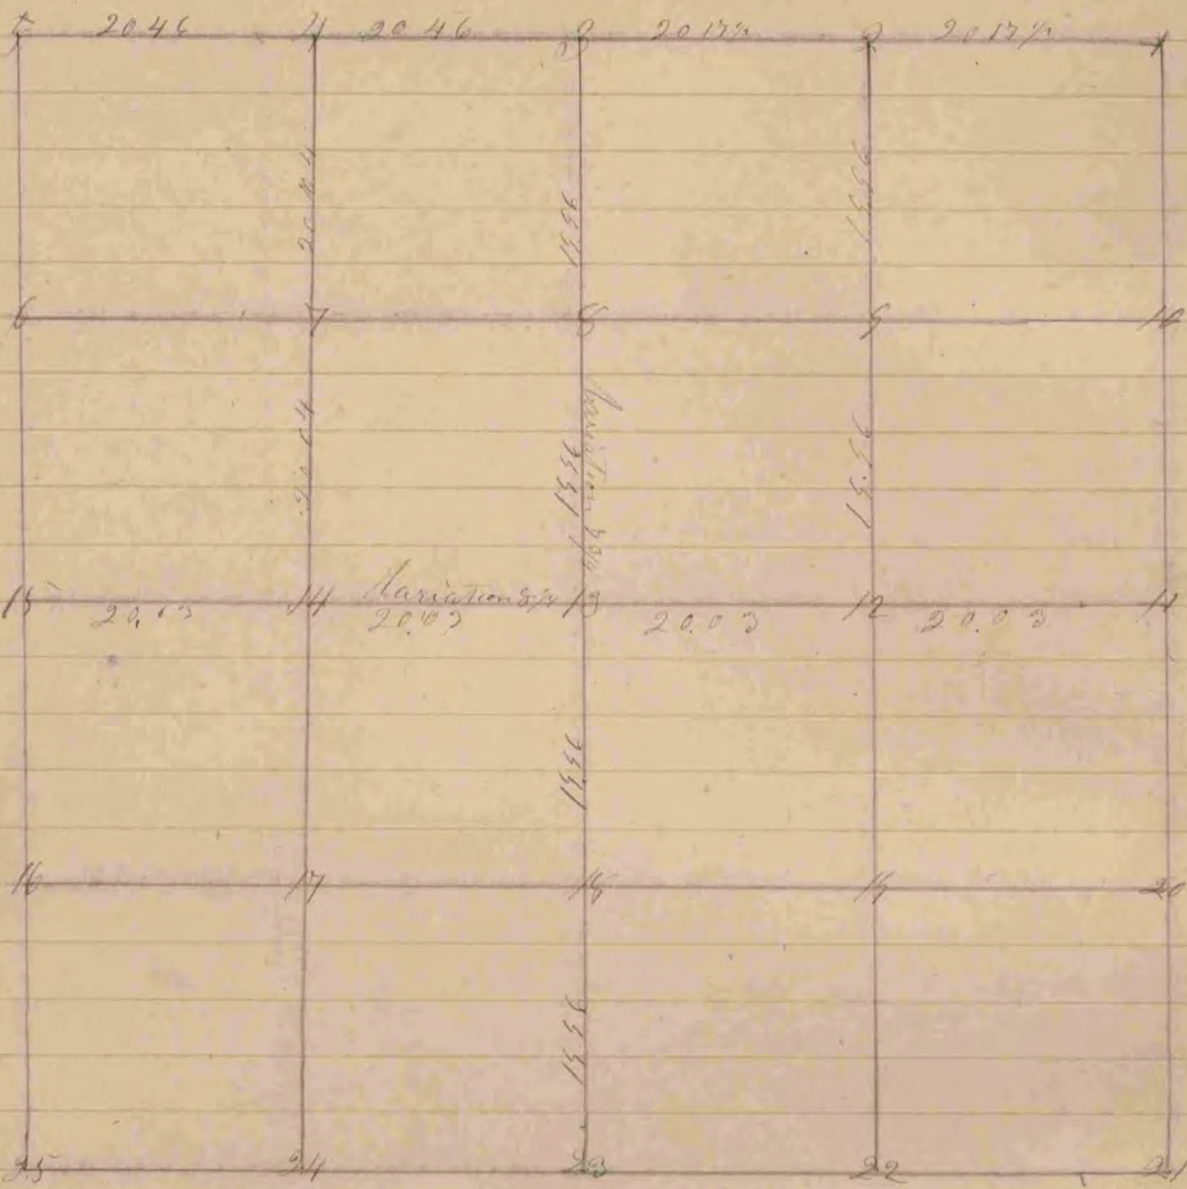

- Fig 13 No 0 14 at 157 6 45
- 7 14 at 17 8 42 Fig 6 No 16 at 45 W 16 1
- 12 W 0 24 at 67 6 28
- No 0 10 at 44 7 71 1/2
- 8 W 0 30 at 79 W 80
- No 0 20 at 85 6 88
- 4 W 0 40 at 65 W 133
- No 0 24 at 11 W 68
- 7 14 at 41 W 52
- 12 at 41 6 16 1/2

The above survey was made the 3<sup>rd</sup> day of March 1856  
Joseph Church  
County Surveyor  
Rock County  
Wis