


RECORD 1859-1906  
COUNTY SURVEYOR

Settlement 20x15x6

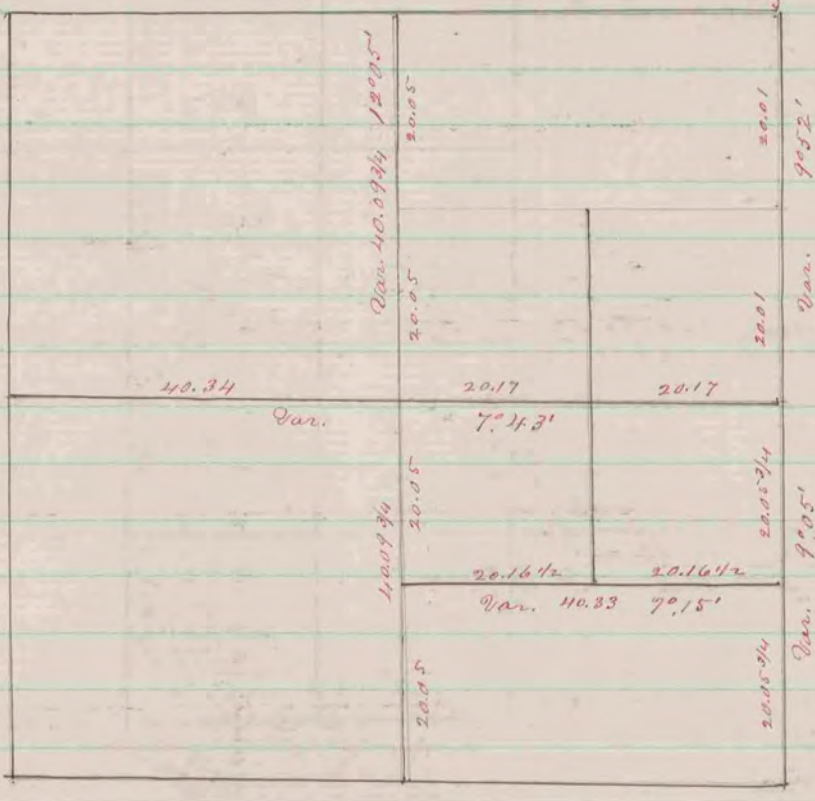

A Record & Plat of a survey made on Sec. 20 & 2  
 R 13. La Prairie April 27-1860  
 By Edward Rege Co. Surveyor

COUNTY SURVEYOR  
RECORD 1859-1906