


Survey on Section 29 T1 N R 13 O

Trust

Surveyed June 10 1859 by  
E. J. Hobart  
Deputy Co Surveyor

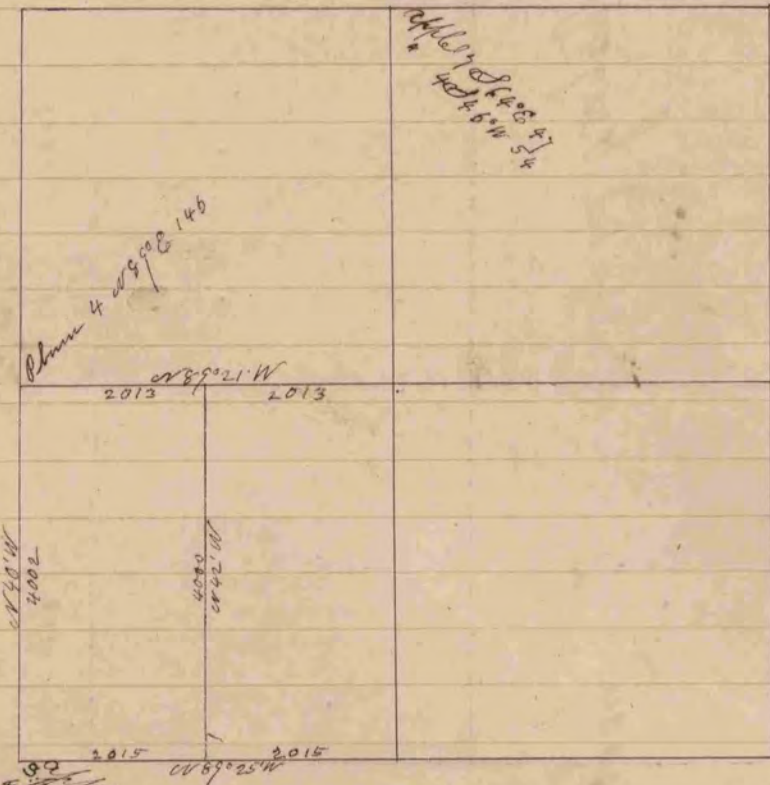

Measurements in links

Variation 5° 30'