


Survey & plat of a survey made on section  
Twenty one town four range ten east

COUNTY SURVEYOR  
RECORD 1 1851-1869

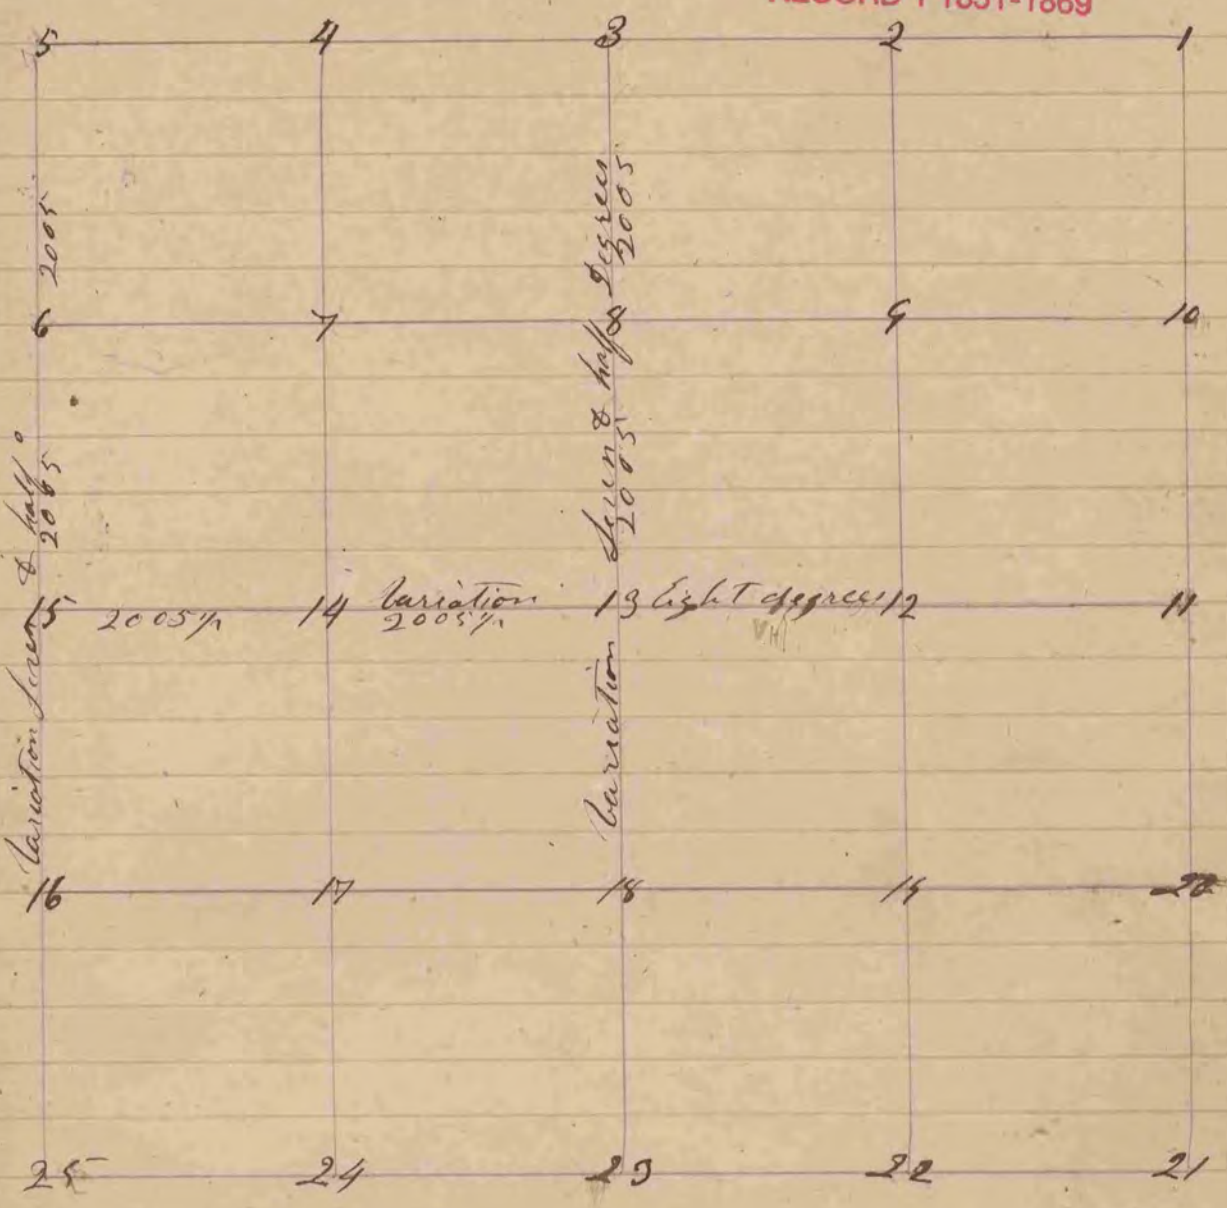

- Fig 13 Stake Standing in the Creek at Side  
no bearings
- " 15 government post not found divided distance  
marked Stake stuck in the marsh  
no bearing  
union

The above Survey was made the tenth  
day of Apr 1857

Joseph Church  
County Surveyor Rock  
County Wis