

76

A Record & Plat of a survey made on See Twenty four Town Three Range Eleven East

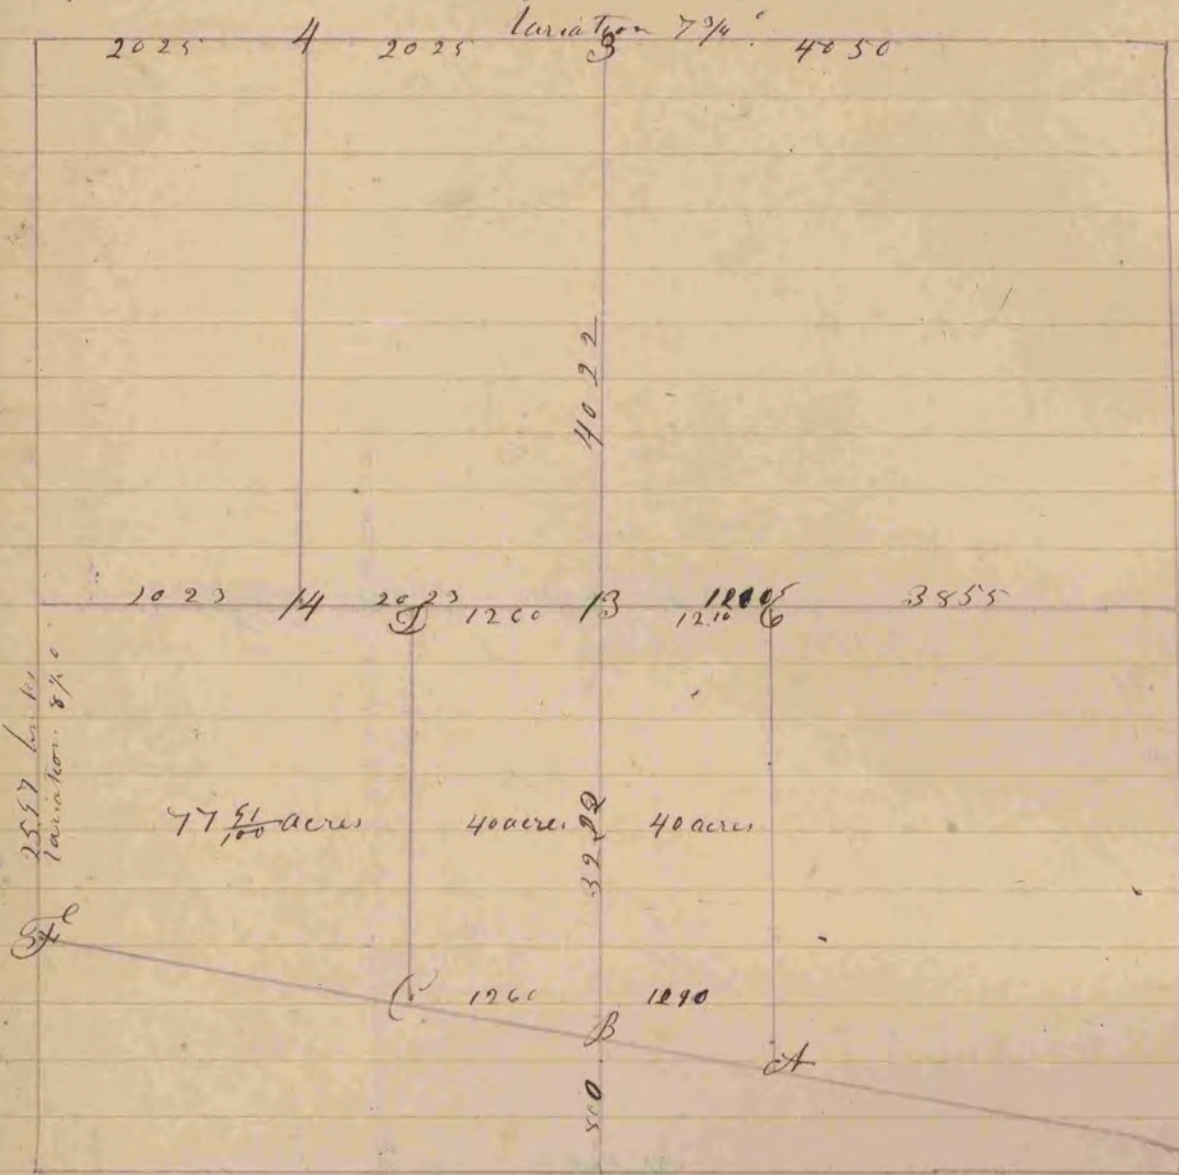


Fig 13 Stone line Stone 8 long 3 thick  
 3 Hard Head Nil Bl Oct 799 E 147  
 Bl 10 S 12 E 241

- Letter A Locust 4 N 32 E 11 3/4 at Side of Road
- B Lime Stone at Side of Road
- C Lime Stone at " " "
- D Hard Head at " " "
- E Stake in the ground
- F Stone Centre

The above survey was made the 17<sup>th</sup> day of April 1857  
 Joseph Church County Surveyor  
 Rock County Wis