


found remains of old stake
& stump of B. H. drove new
stake in place of old one
and surrounded it by 4 hard heads

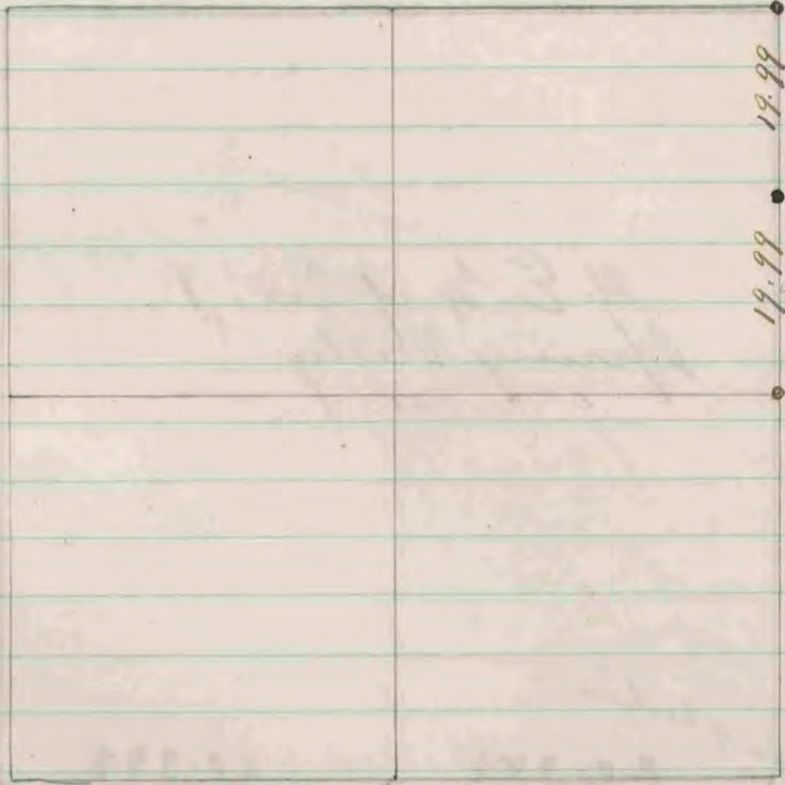

19.99
Drove stake 24-11
7 links W of stump
a little south of west
1/2 link N 60° E to
stump

recorded in private
Record Bk - page 332

The above is a record and plat of a
survey made by me on the 16th of July
July 30 - 1877

Edward Rugg
County Surveyor