


Record of a Survey made for Calvin Binton on
 Section twenty five in the town of Newark

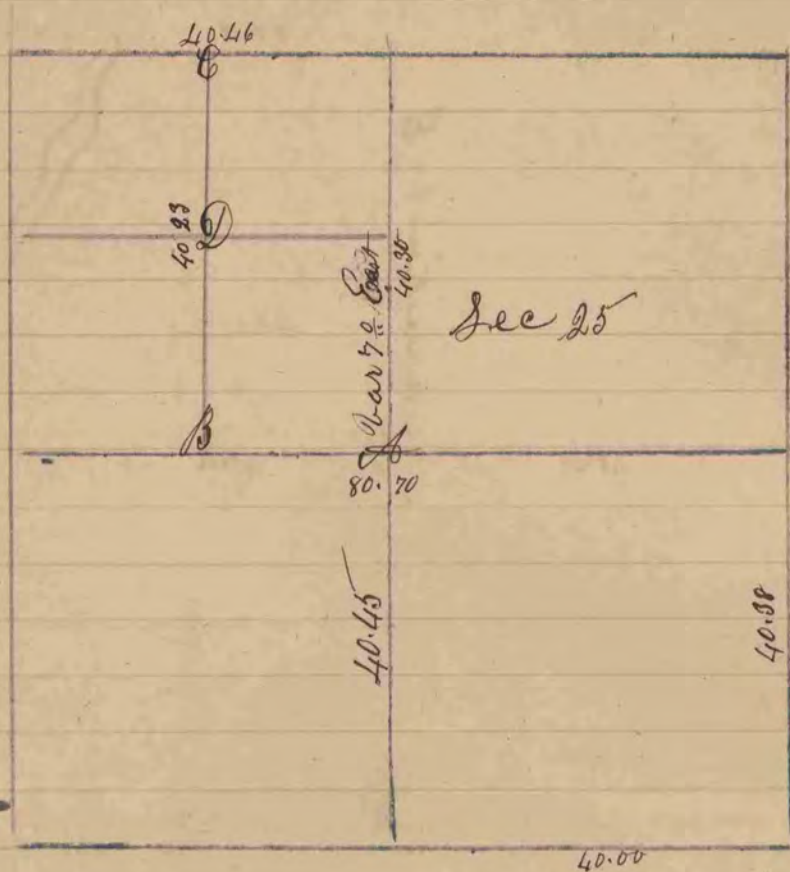

Letter A Represents the centre of the section
 C Br 0 12. S 42 E 26 Also Br 0 22 S 39 W 51 links
 D " " 10 S 27 W 8. Also Yel 0 12 S 30 E 72 links
 D " " 10 N 75 E 28. Also Br 0 12 S 25 W 41 links
 B " " 8. S 50 W 24 links no other surveyed the 7th June
 1857 Peter McBean County Surveyor

COUNTY SURVEYOR
 RECORD 1 1851-1869