

A Record and plat of a survey made on Sec 9 Town four one
Range 14 E

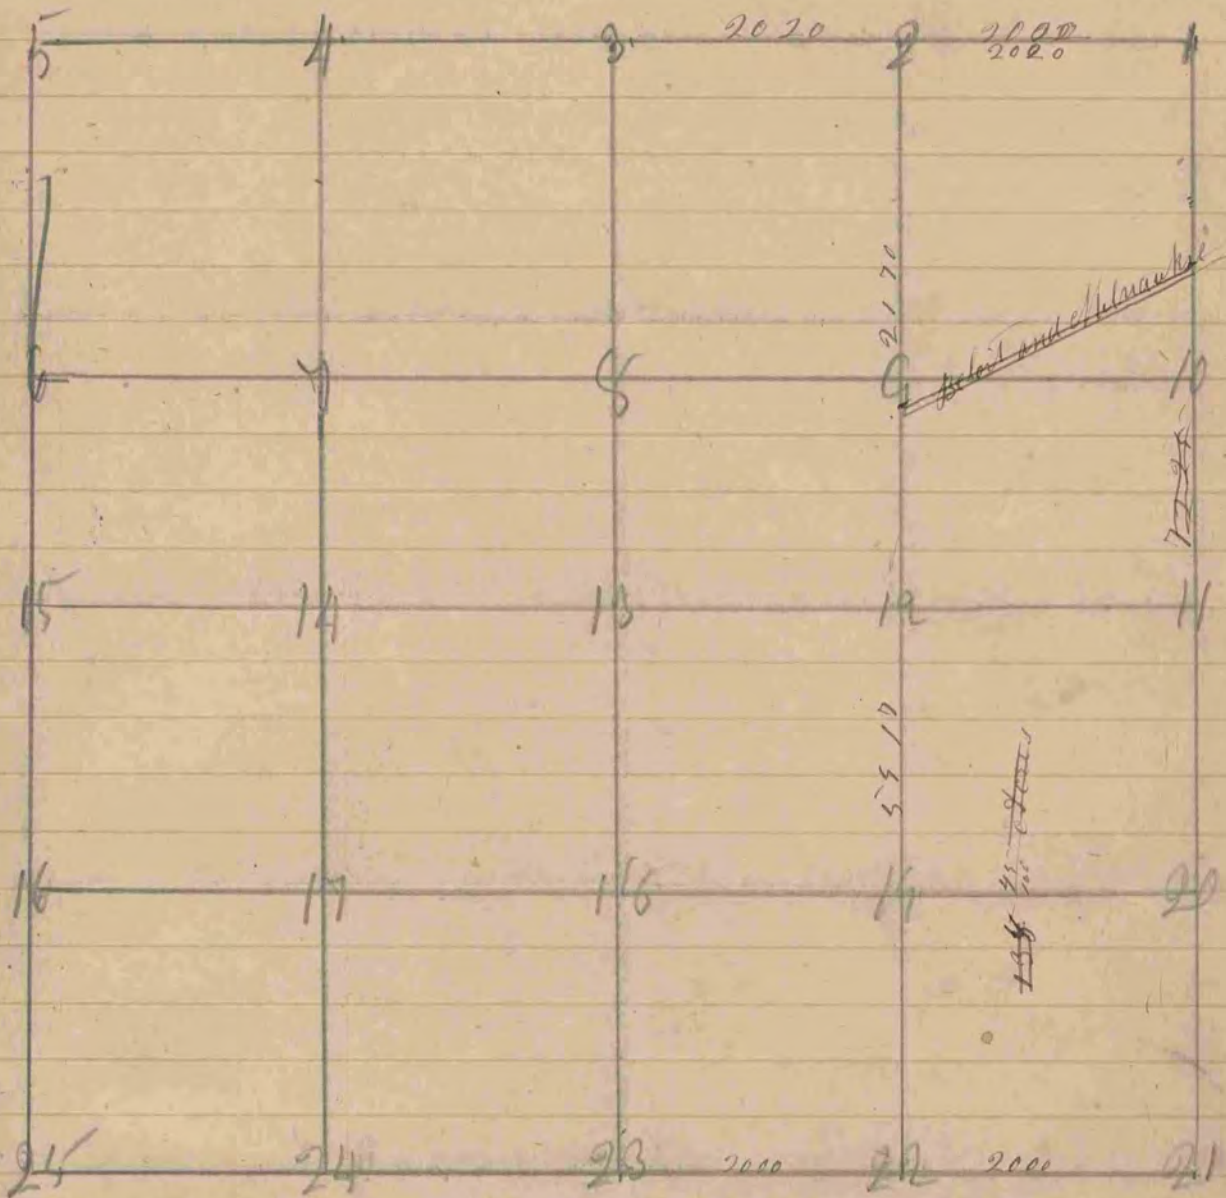


Fig 9 is 2170 links South on the line from Fig 2 and is in the center
of the Beloit and Mellenauke road
Fig 22 Stake and Stone
23 corner
21 post in corner
From Fig 21 to high way 7295 links
The above survey was made the 7th day of Sept 1855

Joseph Church
County Surveyor
Rich County, Ia