

A Record & Plat of a Survey made on <sup>Sec. 33</sup> T2 R. 12 E  
 Rock

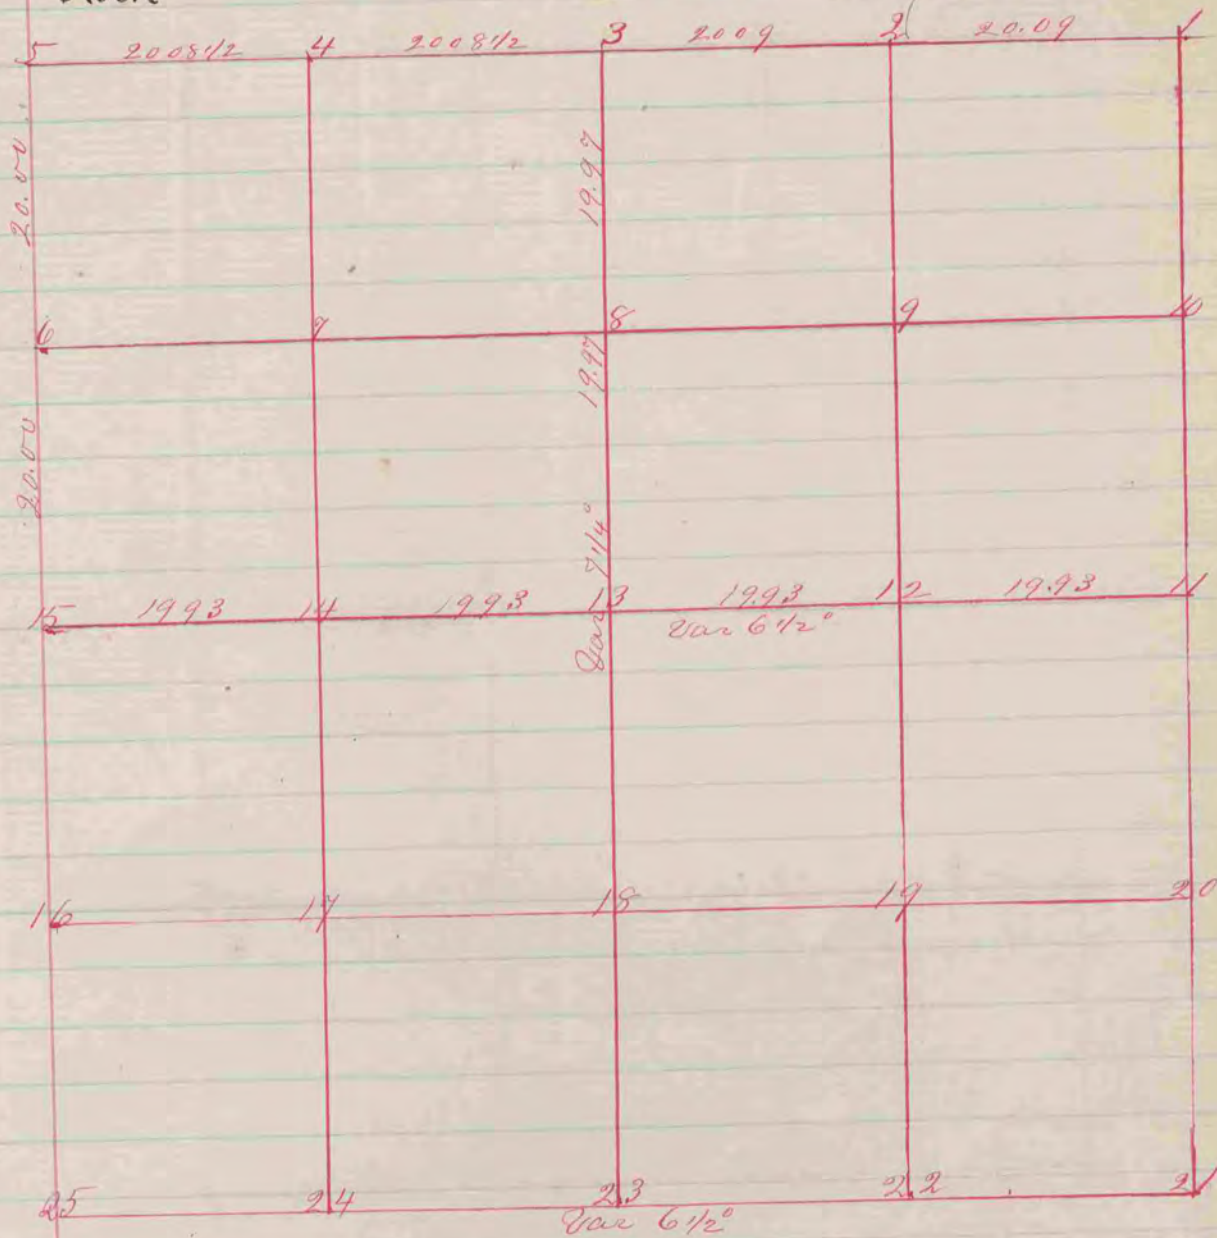


Fig 13 Stake no bearings

14	N.O.	24	N	69 1/4	W	125
"	"	"	N	33 3/4	E	153
4	"	30	S	9 1/2	E	79
	Stump	24	S	36 1/2	W	65
6	N.O.	36	S	86 1/2	E	90
	B.L.O.	16	S	32	W	110
7	N.O.	30	N	55	W	41
"	"	"	N	81	E	54
2	N.O.	12	S	56 1/2	W	96
		8	S	9 1/2	W	70

The above survey was made Jan. 1856  
 Joseph Church Co. Surveyor.

(Recorded in Vol I page 65)