


RECORDED 1881-1882
JAN 11 1882

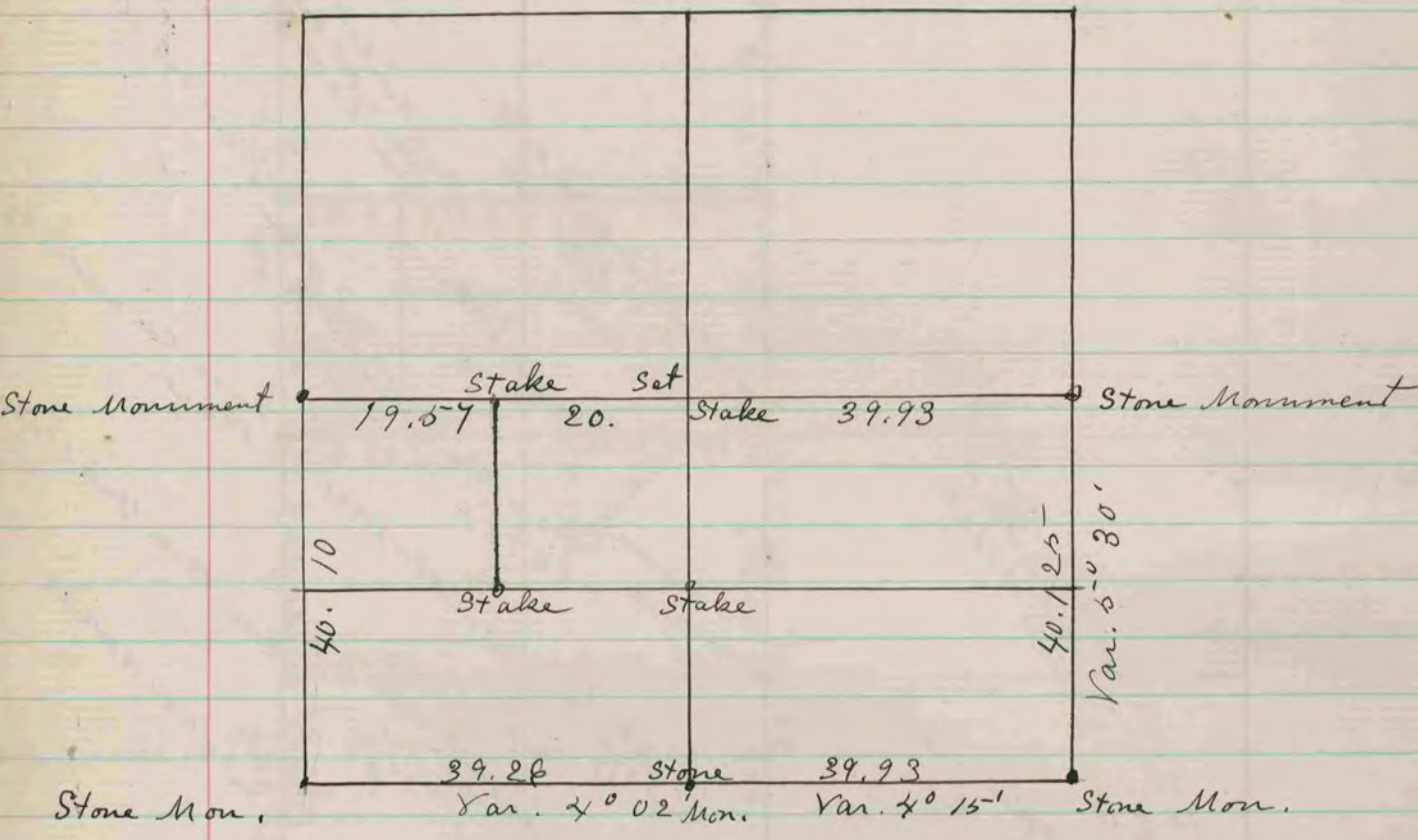

The above is a record & plat of a Survey
made by me on Sec. 31 T. 2. R. 13 (La Prairie)
Nov 18th 1881

John A. Holmes
County Surveyor.