


Corners established  
by self in a former  
survey

11  
Corners established  
by self in a former  
survey

Corners established by  
self in former survey

Corners established  
by self in former  
survey

A fractional lot - 2 of section 26

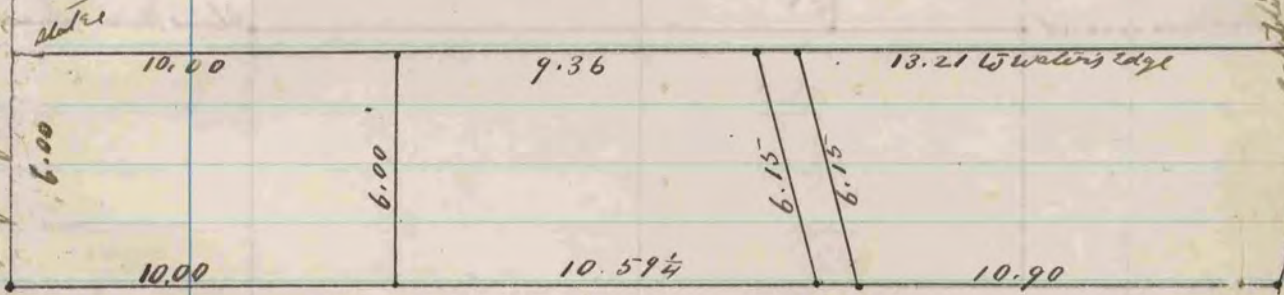

I certify that - The above is a correct record and plot of  
a survey made by me on fractional lot 2  
of section 26 Juneauville May 18 - 1877

Edward Rupp  
County Surveyor

COUNTY SURVEYOR  
EDWARD RUPP  
RECORD 2 1869-1900