
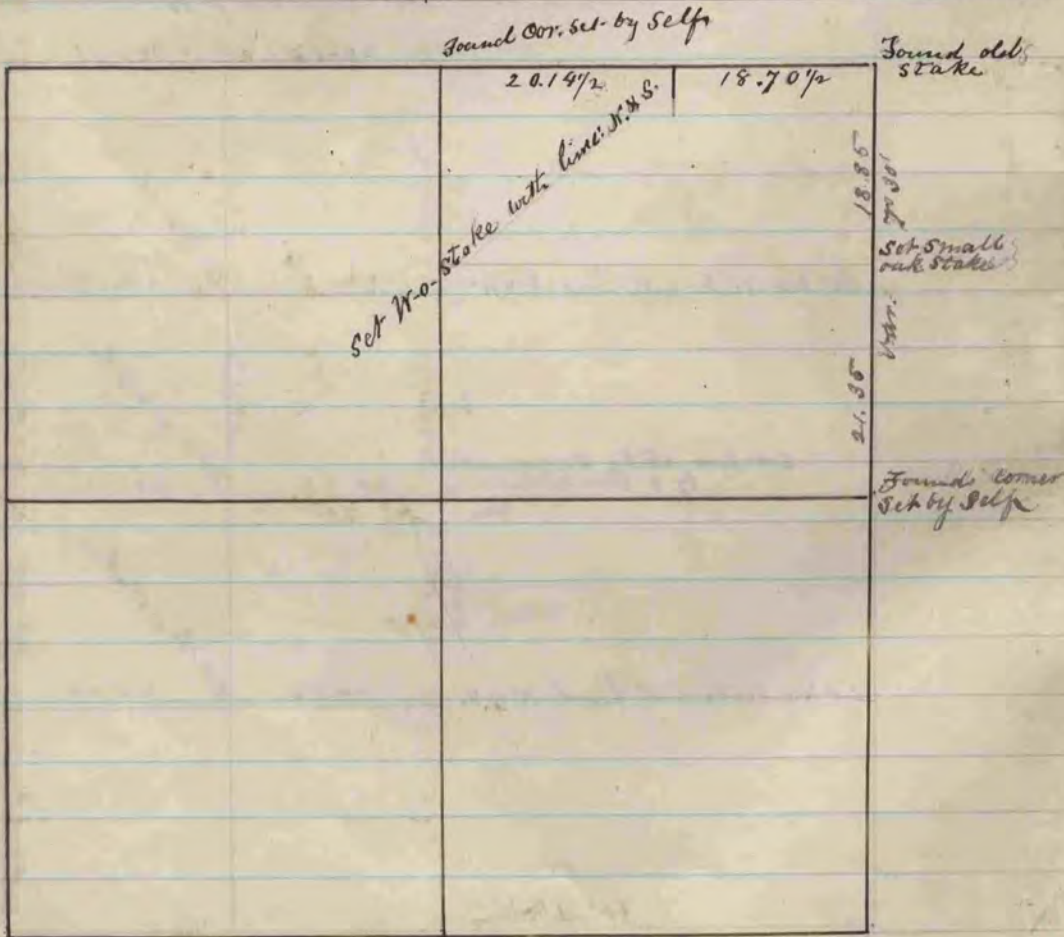


Below is a correct Record & Plat of a Survey  
made by me Oct 30<sup>th</sup> 1869 on Sec 24 T. 2 R. 10  
Spring Valley. R. H. Lee Dep. Co. Surveyor

BOUND BOOK  
OUTSIDE EDGE OF BINDING STAMPED "1869 COUNTY  
SURVEYORS RECORD 2 ROCK COUNTY 1900"

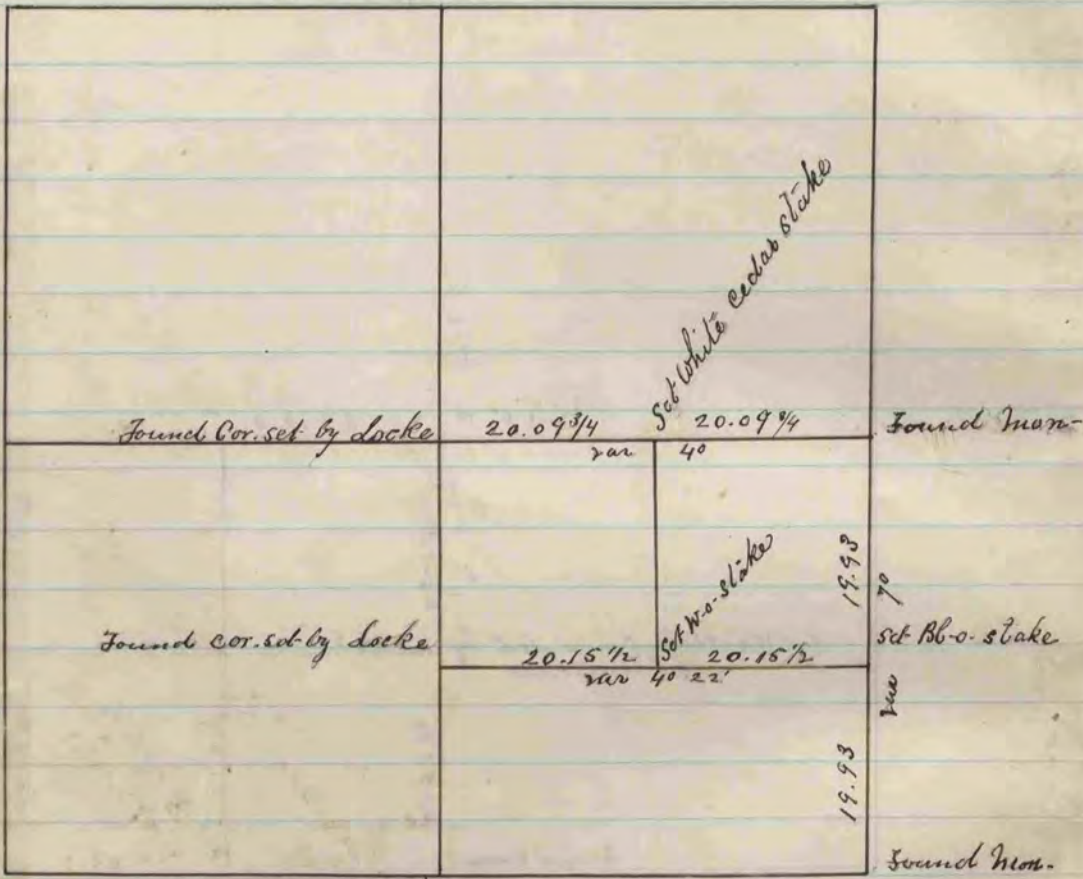

The above is a correct Record & Plat of a Survey  
made by me Nov 1<sup>st</sup> 1869 on Sec 13 T. 2 R. 12  
Rock. R. H. Lee Dep. Co. Surveyor