


The above is a plat and record of a survey made
by me on section 2 Harmony May 27th 1873.
R. K. Lee Dep. Co. Surveyor

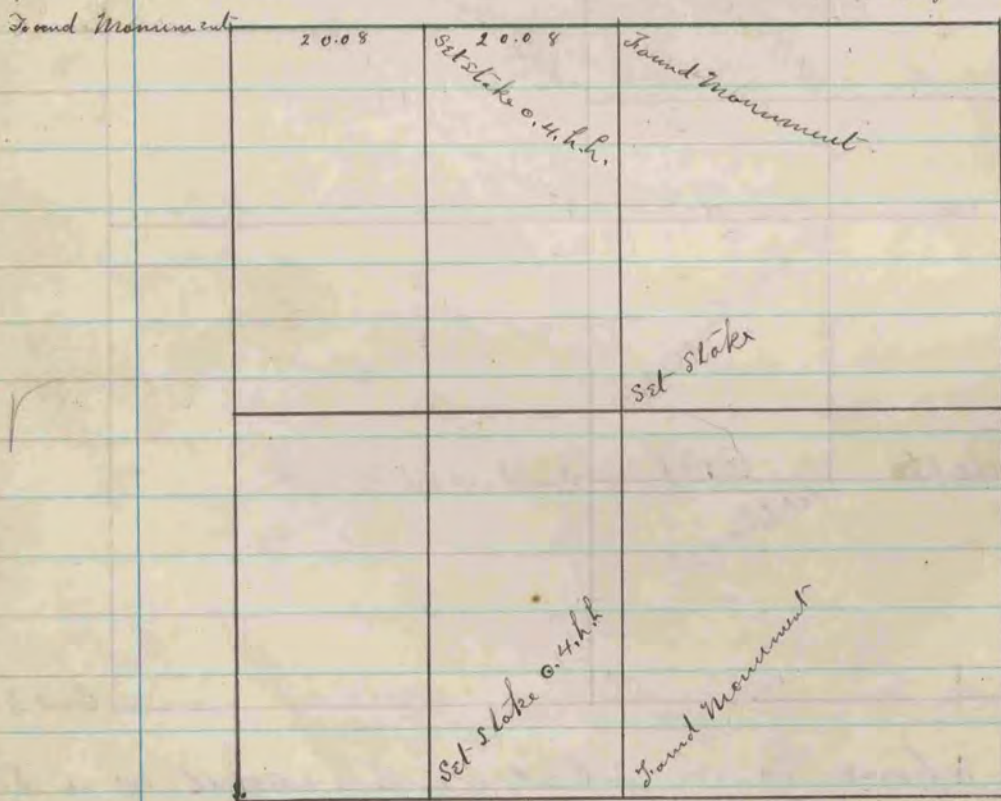

The above is a plat and record of a survey made
on section 35 Milton May 28th 1873.
R. K. Lee Dep. Co. Surveyor